


LEGEND

Legend table with categories: FARM UNITS, DWELLINGS, ETC.; INDUSTRIAL; EDUCATIONAL AND CORRECTIONAL INSTITUTIONS; CONSERVATION OR RECREATION; STRUCTURES; PUBLIC SERVICE FACILITIES; AIRWAYS; CITY OR VILLAGE CENTERS; MISCELLANEOUS MAP FEATURES-NATURAL FEATURES; RAILROADS; NAVIGATION AND DRAINAGE; BOUNDARIES; ROADS AND ROADWAY FEATURES.

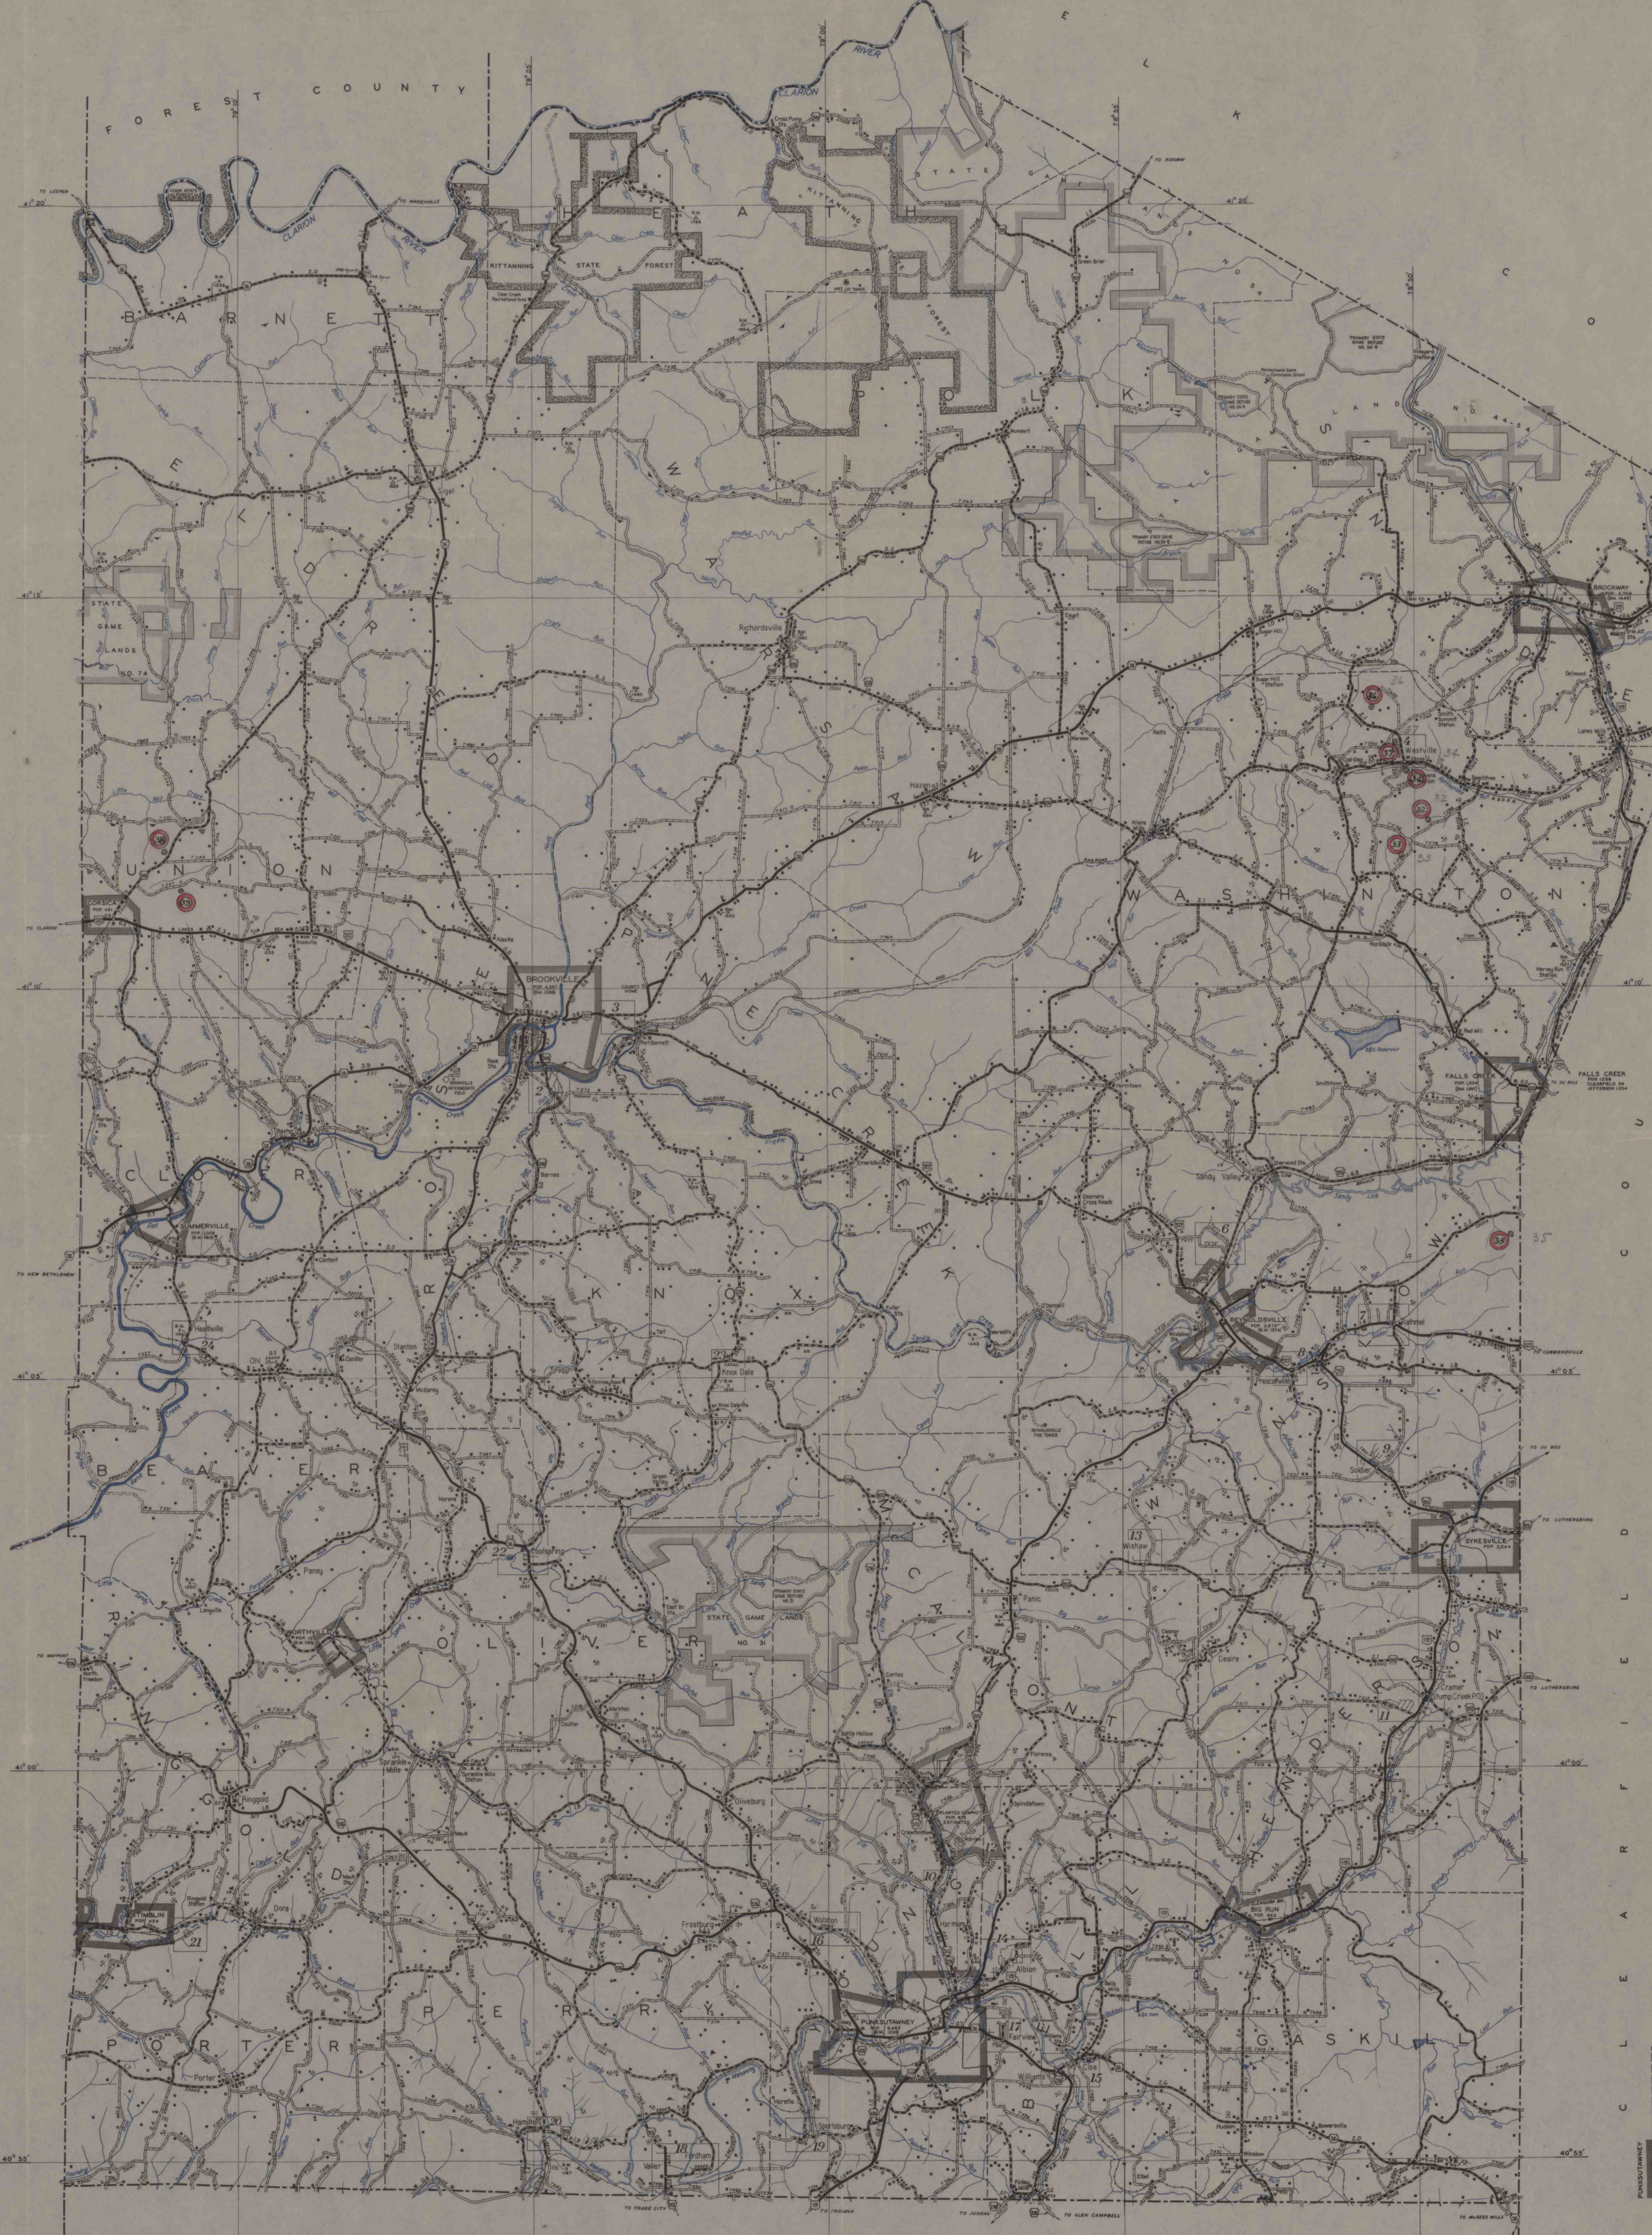

Inset maps (1-14) showing detailed views of specific areas. A north arrow and scale bar are present. Text includes: 'Robert J. Emigh, State Mine Inspector, Fourth Bit District, DuBois, Penna.', 'GENERAL HIGHWAY MAP, JEFFERSON COUNTY, PENNSYLVANIA', 'PENNSYLVANIA DEPARTMENT OF HIGHWAYS, PUBLIC ROADS ADMINISTRATION, FEDERAL WORKS AGENCY, STATE-WIDE HIGHWAY PLANNING SURVEY', '1941 CULTURE FIGURES AS OF 1939', and 'POLYCONIC PROJECTION'.