

LEGEND

- AIR ROUTE**

ARMY, NAVY OR MARINE CORPS FIELD

CIVIL AERONAUTICS AUTHORITY INTERMEDIATE FIELD

COMMERCIAL OR AERONAUTIC FIELD

APPROXIMATE LANDING FIELD (DASHED LINE)

LANDMARK LIGHT BEACON

RAVINE

CITY OR VILLAGE CENTERS
 COUNTY SEAT
 OTHER CITIES AND VILLAGES
 INCORPORATED CITIES OR BORDERS
 UNINCORPORATED URBAN COMPLEX
- MISCELLANEOUS MAP FEATURES-NATURAL FEATURES**

ARROYO

FORT, ARMY CAMP OR BARRACKS

ARMY BARRICADE

ROADSIDE SPRING

TRAVELING STATION

BENCH MARK

TRAIL AND LONGITUDE LINES

MONUMENT

STATE PARK, RECREATION AREA, HISTORIC SITE

POINTS BETWEEN WHICH DISTANCES ARE MEASURED

PROMINENT ELEVATION WITH NAME

RAIL OR SUPERSEDED TRAIL

PREHISTORIC MOUND
- RAILROADS**

RAILROAD

ELECTRIC INTERURBAN OR SUBURBAN RAILROAD

RAILROAD STATION

RAILROAD CROSSING

RAILROAD BRIDGE

RAILROAD TUNNEL

STANDARD GAUGE RAILROAD ON BRIDGE OR TUNNEL

NARROW GAUGE RAILROAD

ELECTRIC RAILROAD
- NAVIGATION AND DRAINAGE**

SHIP AND CANAL LOCK

DOCK, PIER OR LAUNDRY

TIDAL FERRY

HEAD OF NAVIGATION

HEAD OF NAVIGATION (RIVER NAME)

CANAL

UNIMPROVED CANAL

DAM WITH ROAD AND LOCK


DAM WITH LOCK

WEIR

MARSH OR SWAMP LAND

RESERVOIR

RESERVOIR WITH DAM

MARSHED STREAM

NARROW STREAM

STATE STREAM

WATER COURSE

WATER COURSE WITH DAM


- BOUNDARIES**

STATE LINE

TOWNSHIP LINE

UNINCORPORATED URBAN COMPLEX LINE

STATE GAME RESERVE LINE

STATE GAME LAND LINE

STATE FOREST LAND LINE

OTHER STATE OR FEDERAL PUBLIC LAND LINE
- ROADS AND HIGHWAY FEATURES**

FEDERAL AND SECONDARY HIGHWAY SYSTEM

STATE AID ROAD

TRAFFIC CIRCLE

UNIMPROVED ROAD

GRAVEL OR STONE ROAD

ROAD UNDER CONSTRUCTION

CONCRETE OR BRICK ROAD
- FARM UNITS, DWELLINGS, ETC.**

FARM UNIT

RESIDENCE

INDUSTRIAL

STORE OR SMALL BUSINESS ESTABLISHMENT

FACTORY OR INDUSTRIAL PLANT

CENTRAL POWER PLANT

WATER TOWER

WINDMILL




- EDUCATIONAL AND CORRECTIONAL INSTITUTIONS**

SCHOOLHOUSE

CONSOLIDATED OR LARGE SCHOOL

OTHER EDUCATIONAL INSTITUTIONS

PUBLIC LIBRARY

MUSEUM

TOWN HALL, GRANGE OR COMMUNITY HALL

BOYS' CLUB

CORRECTIONAL INSTITUTION

COUNTY JAIL
- CONSERVATION OR RECREATION**

MUNICIPAL PARK

PUBLIC GARDEN

ATHLETIC FIELD, ETC.

BATHING BEACH OR SWIMMING POOL

BOAT RAMP

CAMP

TRAIL CAMP




- STRUCTURES**

HIGHWAY BRIDGE AND TYPICALLY

SMALL BRIDGE

COVERED BRIDGE

DRYBRIDGE




- PUBLIC SERVICE FACILITIES**

POST OFFICE


POWER PLANT





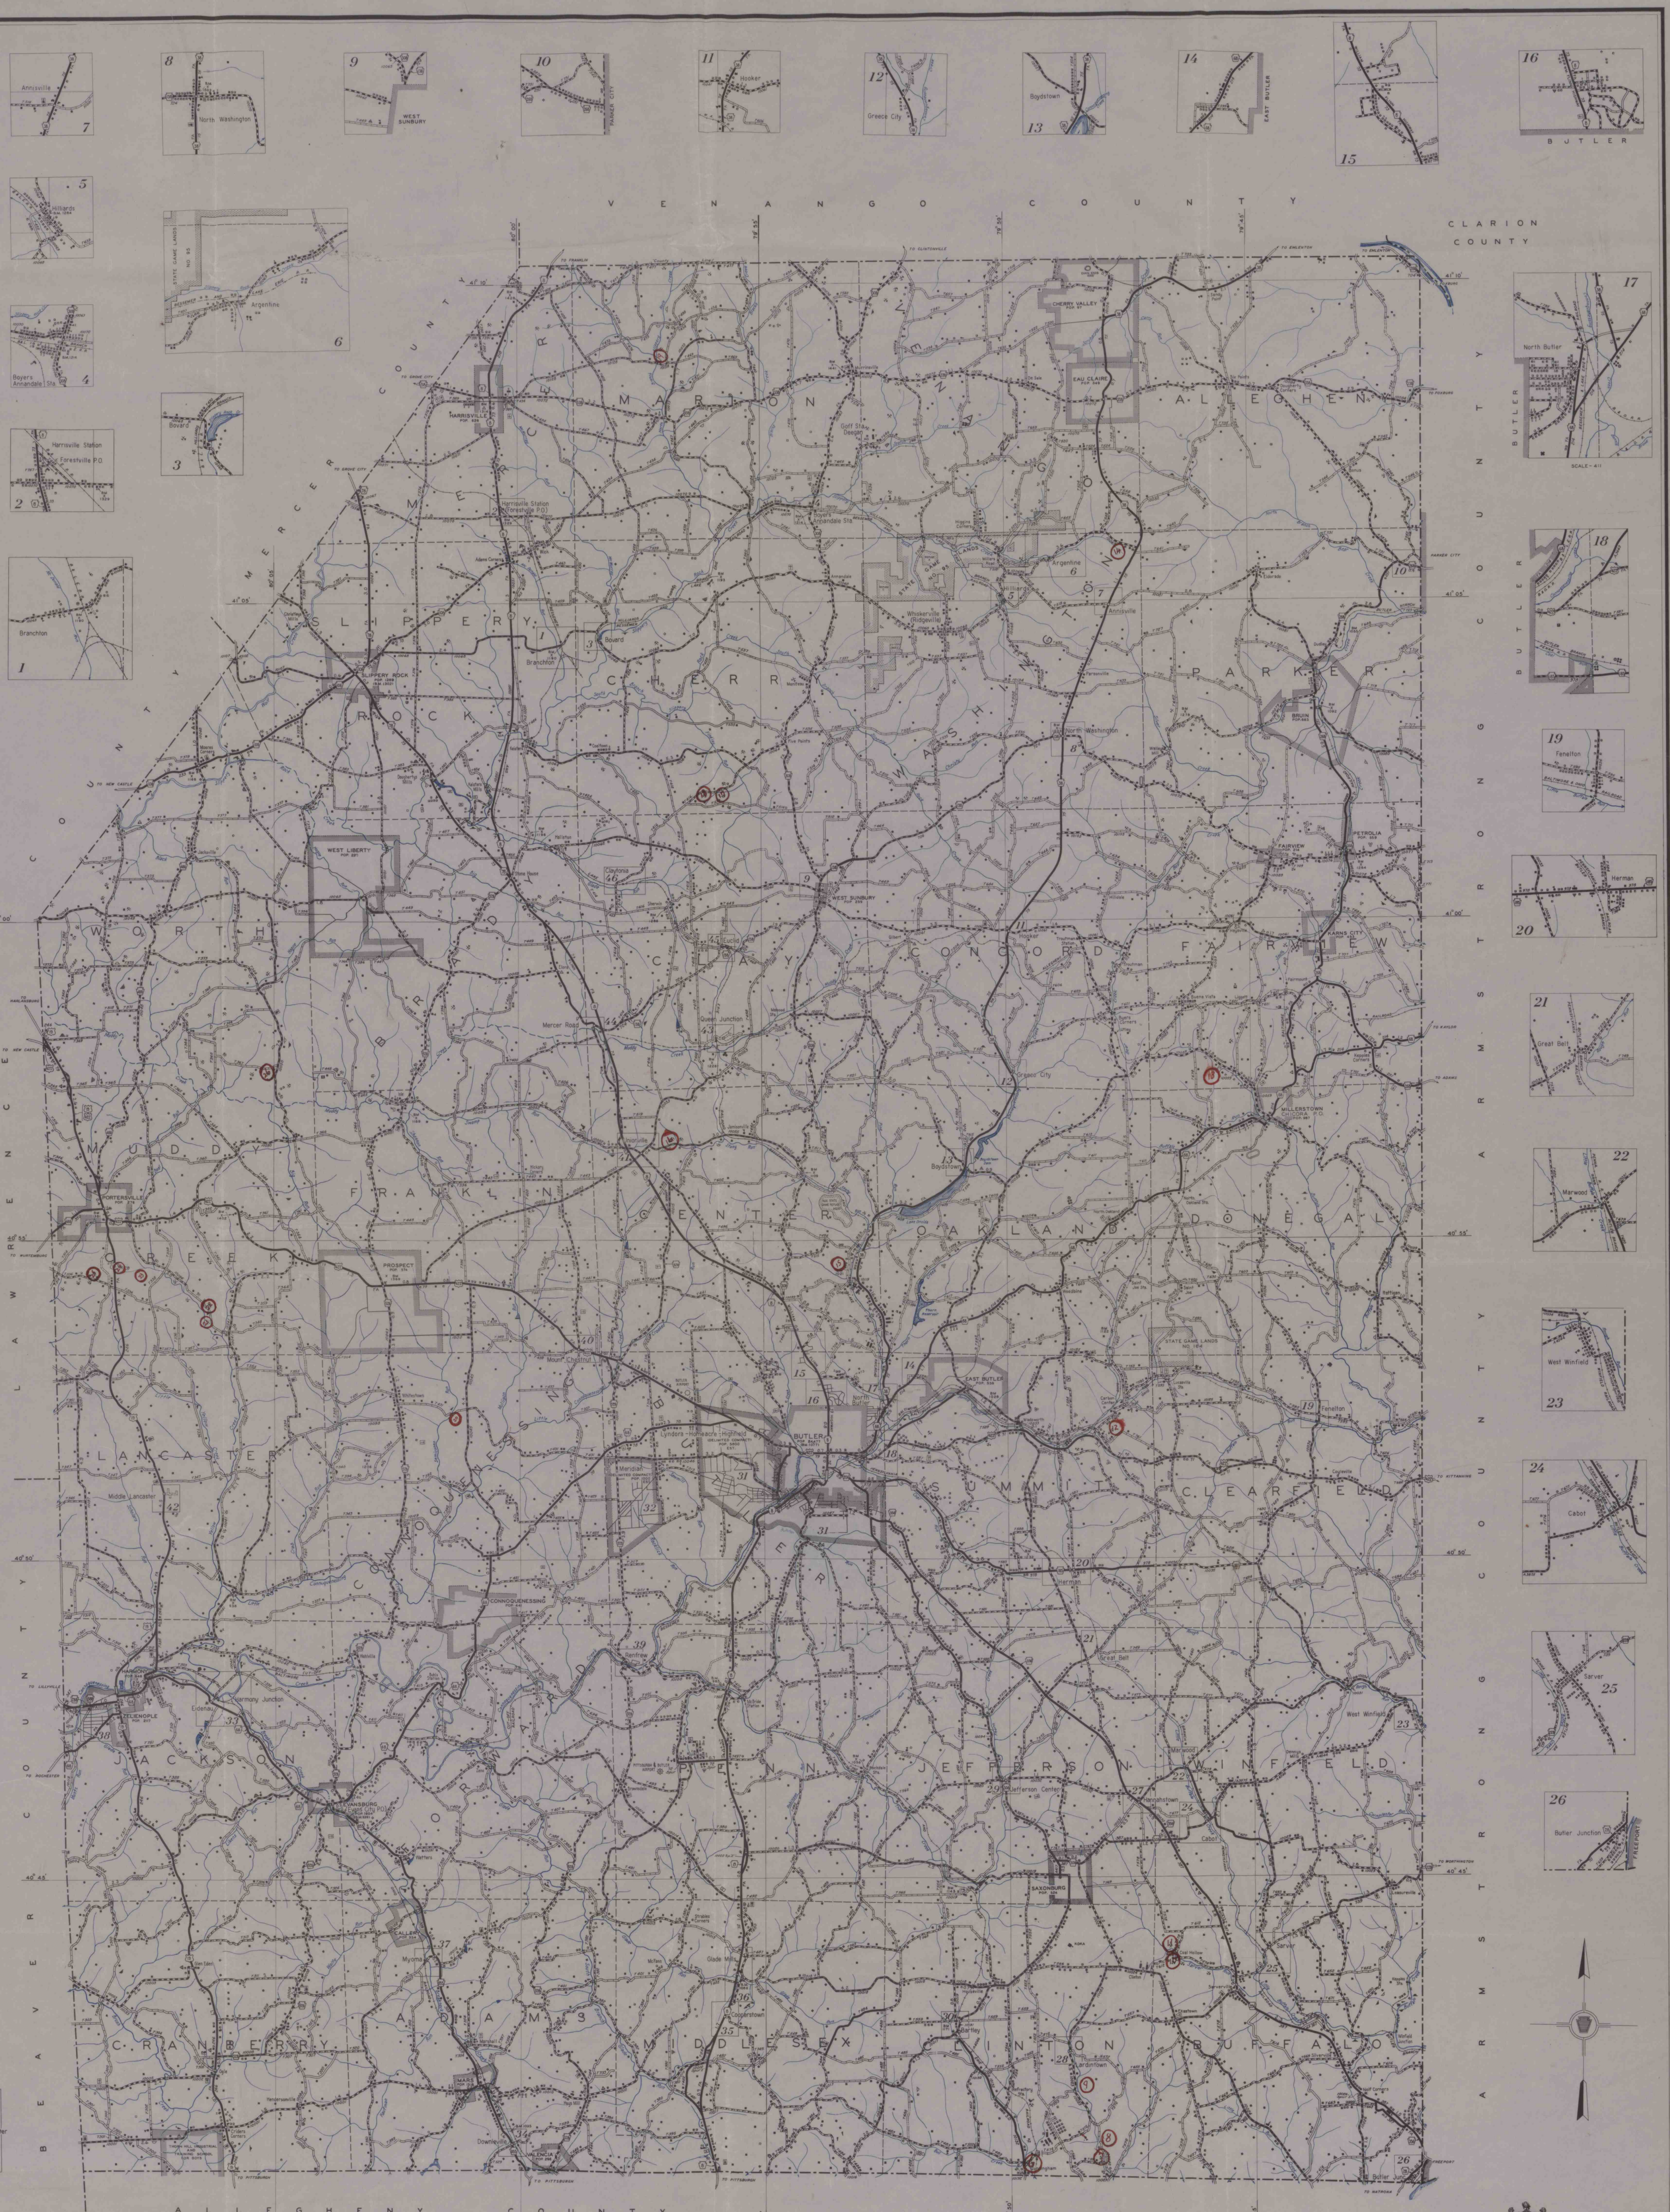

GENERAL HIGHWAY MAP

BUTLER COUNTY

PENNSYLVANIA

PREPARED BY THE
 PENNSYLVANIA DEPARTMENT OF HIGHWAYS
 IN COOPERATION WITH THE
 FEDERAL WORKS AGENCY
 PUBLIC ROADS ADMINISTRATION
 DATA OBTAINED FROM
 STATE-WIDE HIGHWAY PLANNING SURVEY

SCALE: 1" = 10 MILES

ENLARGEMENT SCALE: 1" = 5 MILES

1941

CULTURE FEATURES AS OF 1938

KEY MAP





 Lyndon-Homestead-Highfield



 Mifflin



 Westfield










BUTLER COUNTY, PENNSYLVANIA
 1941
 STATE-WIDE HIGHWAY PLANNING SURVEY