


MAP OF BEAVER COUNTY

SCALE
0 1 2 3 MILES

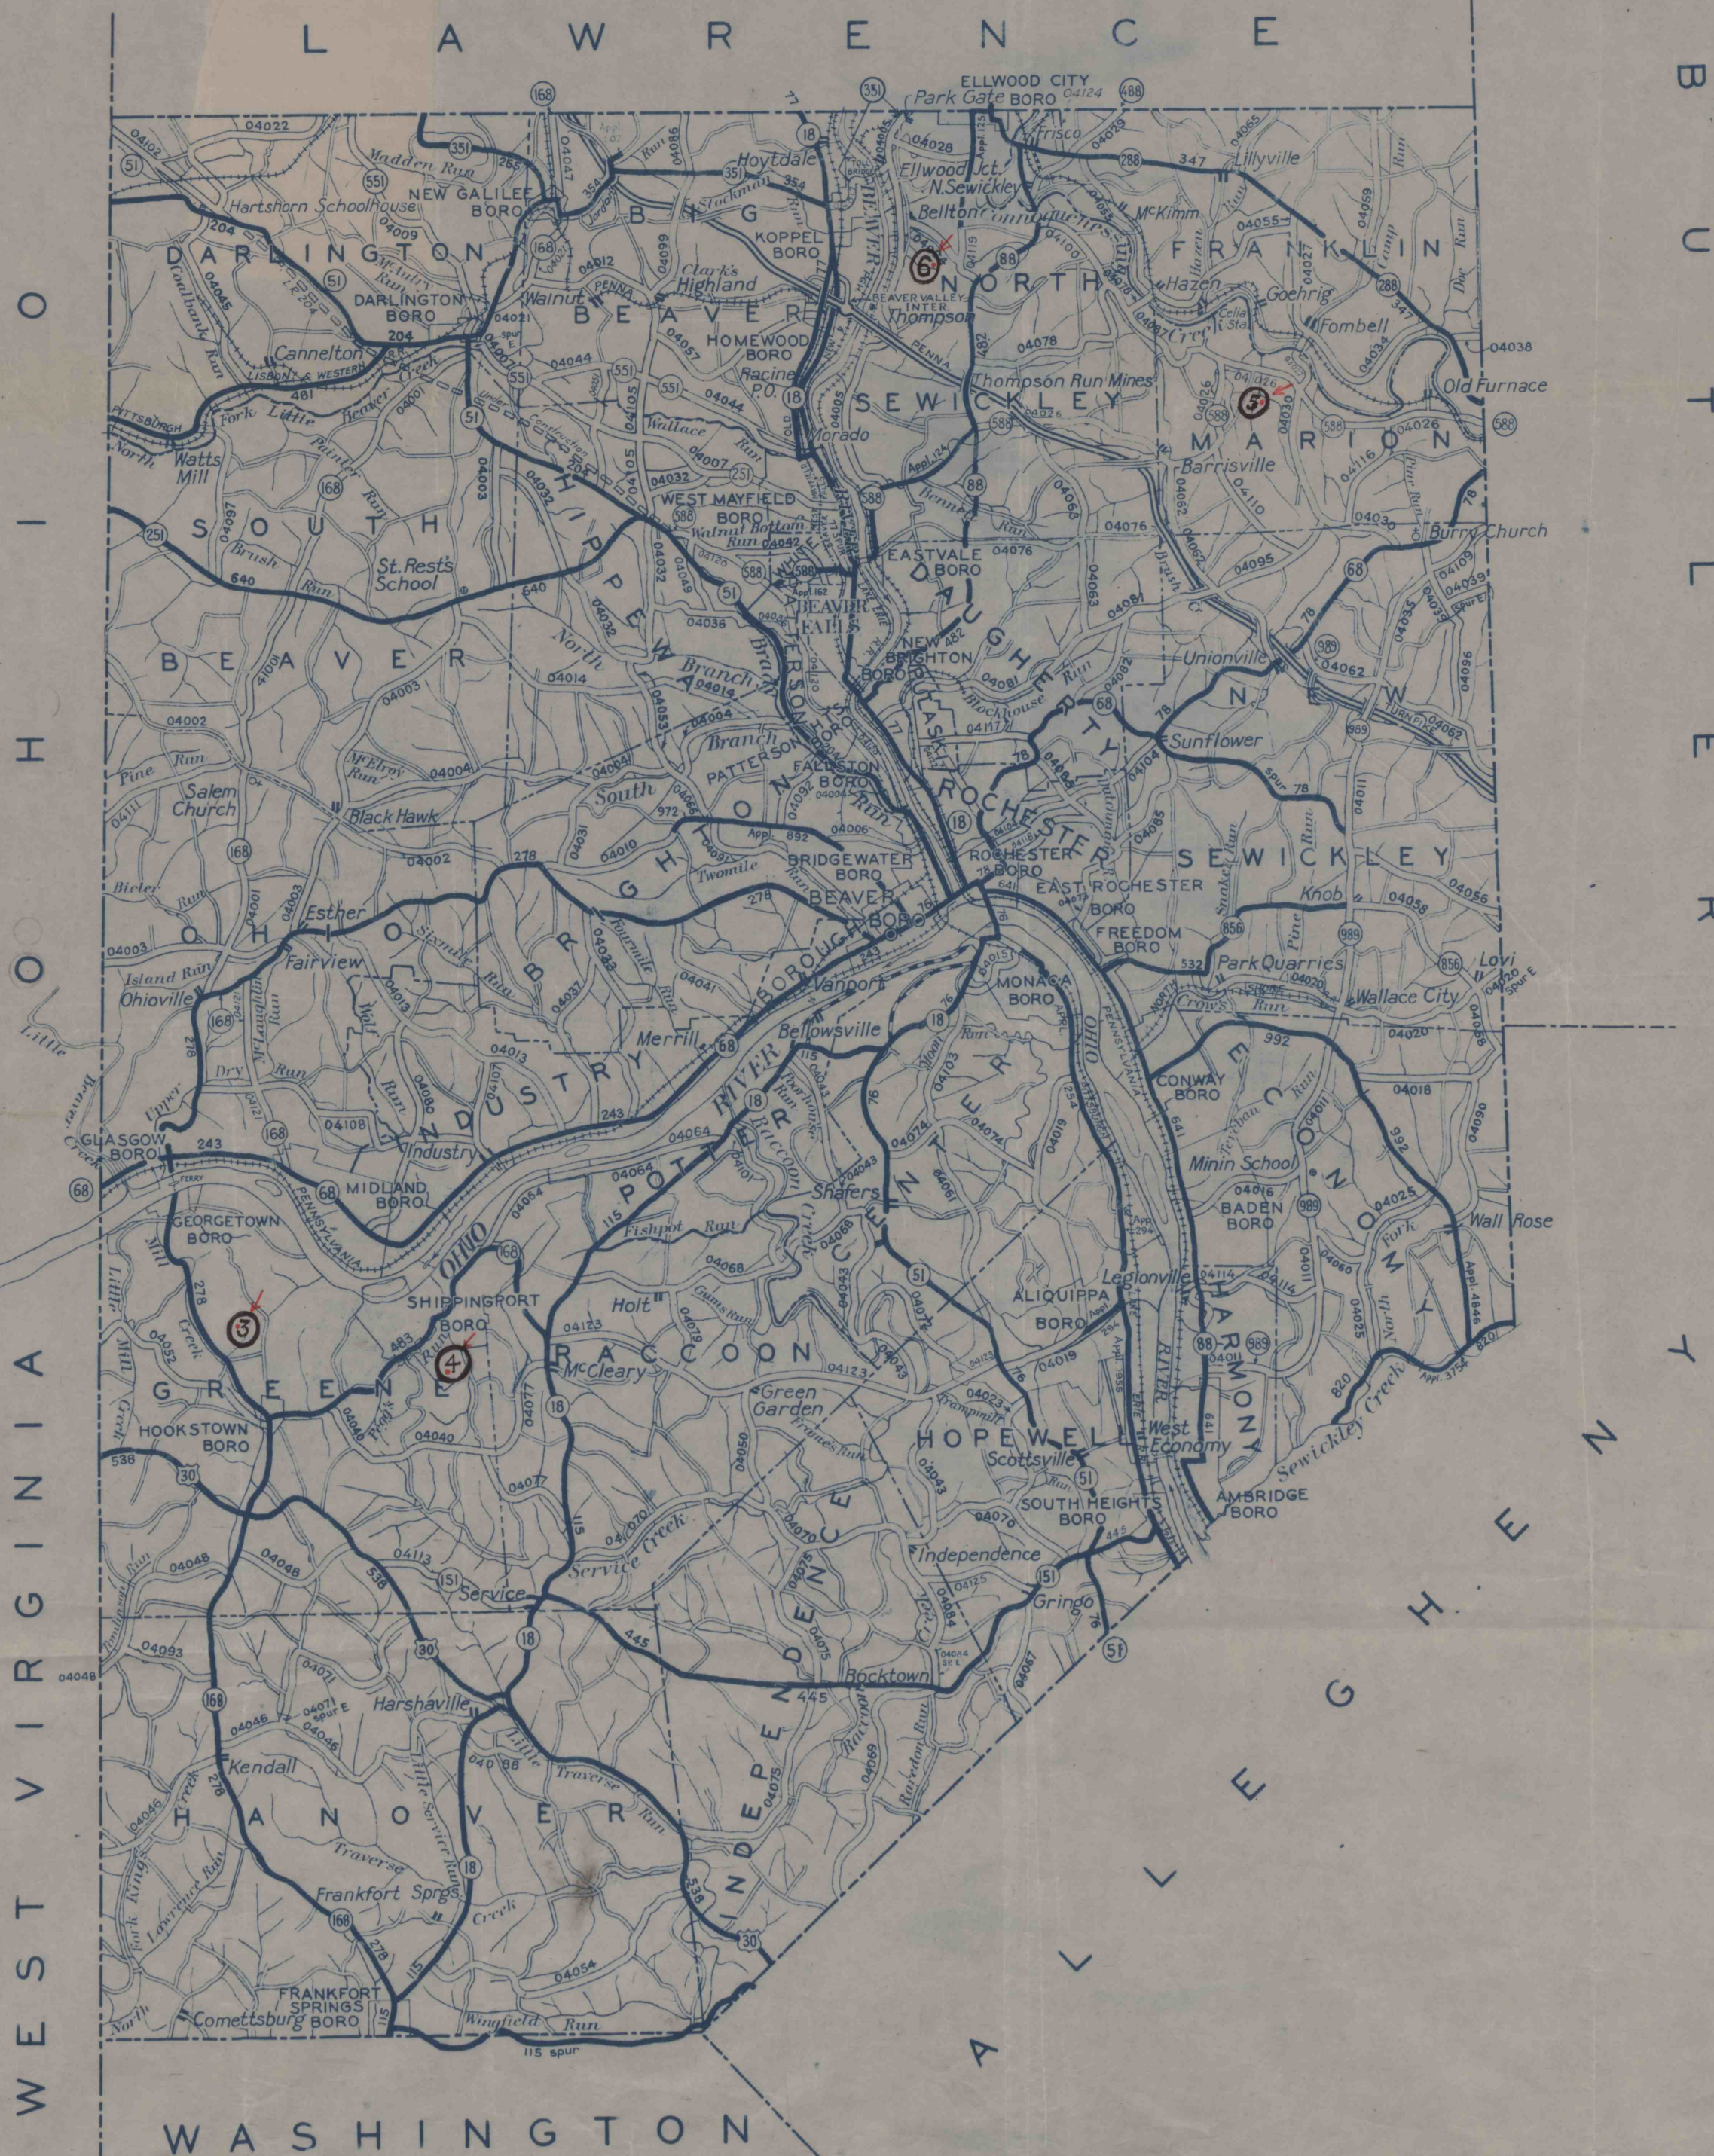

- COMMONWEALTH OF PENNSYLVANIA
DEPARTMENT OF HIGHWAYS
HARRISBURG
- LEGEND
- STATE HIGHWAYS—OLD SYSTEM
 - STATE HIGHWAYS—RURAL ROUTE SYSTEM
 - COUNTY ROADS
 - TOWNSHIP ROADS
 - U.S. AND STATE HIGHWAY TRAFFIC ROUTE NUMBERS
 - U.S. AND STATE HIGHWAY TRAFFIC ROUTE NUMBERS
 - STATE HIGHWAY LEGISLATIVE ROUTE NUMBERS
 - STATE HIGHWAY LEGISLATIVE ROUTE NUMBERS

APRIL 1952.