


LEGEND

- RAILROADS
  - RAILROAD
  - RAILROAD CROSSING
  - RAILROAD TUNNEL
  - RAILROAD BRIDGE
  - RAILROAD UNDERPASS
  - RAILROAD GRADE
- NAVIGATION AND DRAINAGE
  - SHIP AND BARGE CANALS
  - LOCK
  - DAM WITH ROAD AND LOCK
  - LOCK-CANAL
  - WIDE STREAM
  - HEAD OF STREAM
- BOUNDARIES
  - STATE LINE
  - COUNTY LINE
  - TOWNSHIP LINE
  - CORPORATE LINE
  - UNINCORPORATED URBAN COMPACT LINE
  - ENLARGEMENT INLET LINE
  - STATE GAME LAND LINE
  - STATE GAME LAND LINE WITH PUBLIC LAND LINE
  - OTHER STATE AND FEDERAL BOUNDARIES
- STREET LIGHTS AND SIGNALS
  - FEDERAL TRAFFIC ROUTE NUMBER
  - PENNSYLVANIA TRAFFIC ROUTE NUMBER
  - PENNSYLVANIA LEGISLATIVE ROUTE NUMBER
  - ROAD NOT THE LEGAL RESPONSIBILITY OF THE STATE OR ITS SUBSIDIARIES
  - UNINCORPORATED URBAN COMPACTS AND EXTENSIONS TO LOCAL ROADS WITHIN MUNICIPALITIES

- 12
- 13
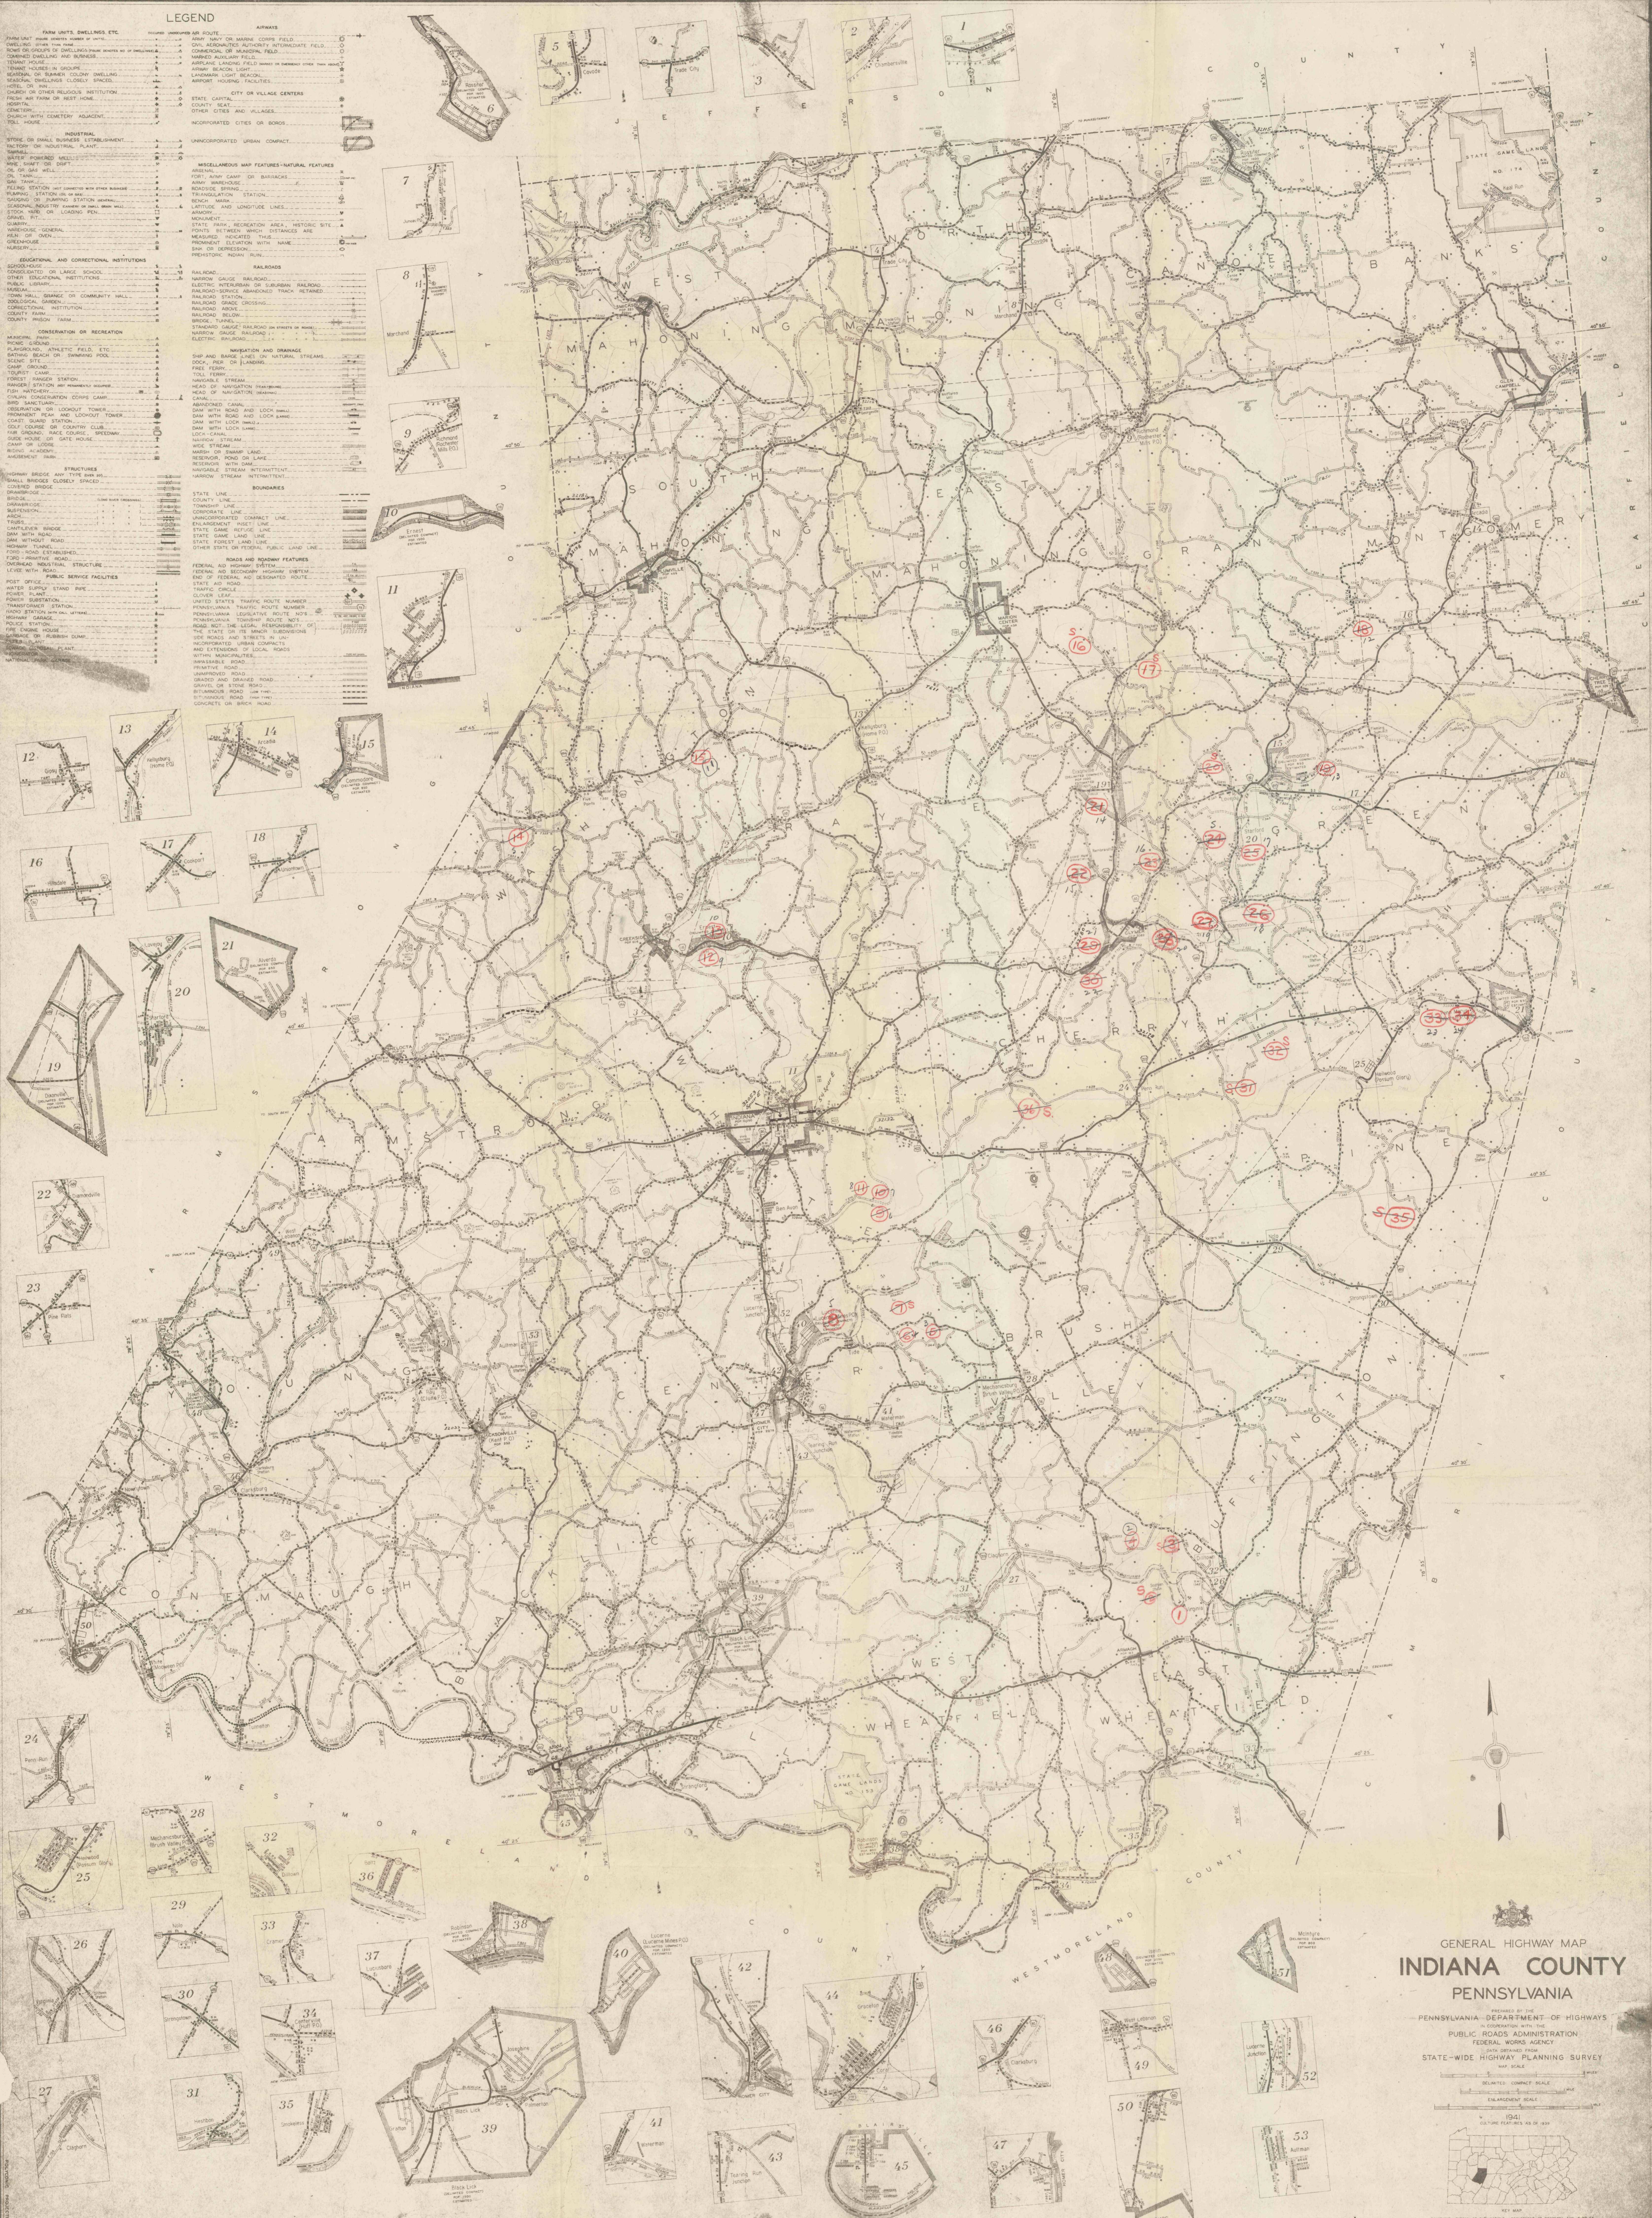

GENERAL HIGHWAY MAP  
**INDIANA COUNTY**  
PENNSYLVANIA

PREPARED BY THE  
PENNSYLVANIA DEPARTMENT OF HIGHWAYS  
IN COOPERATION WITH THE  
PUBLIC ROADS ADMINISTRATION  
FEDERAL WORKS AGENCY  
STATE-WIDE HIGHWAY PLANNING SURVEY  
MAY 1941

UNENLARGED SCALE  
ENLARGED SCALE

1941  
CITY AND TOWNSHIP BOUNDARIES AS OF 1941