

152 QUARRY

Nº 17 QUARRY

840
820
800
780
760
740
720

11


10

9

8

7

6

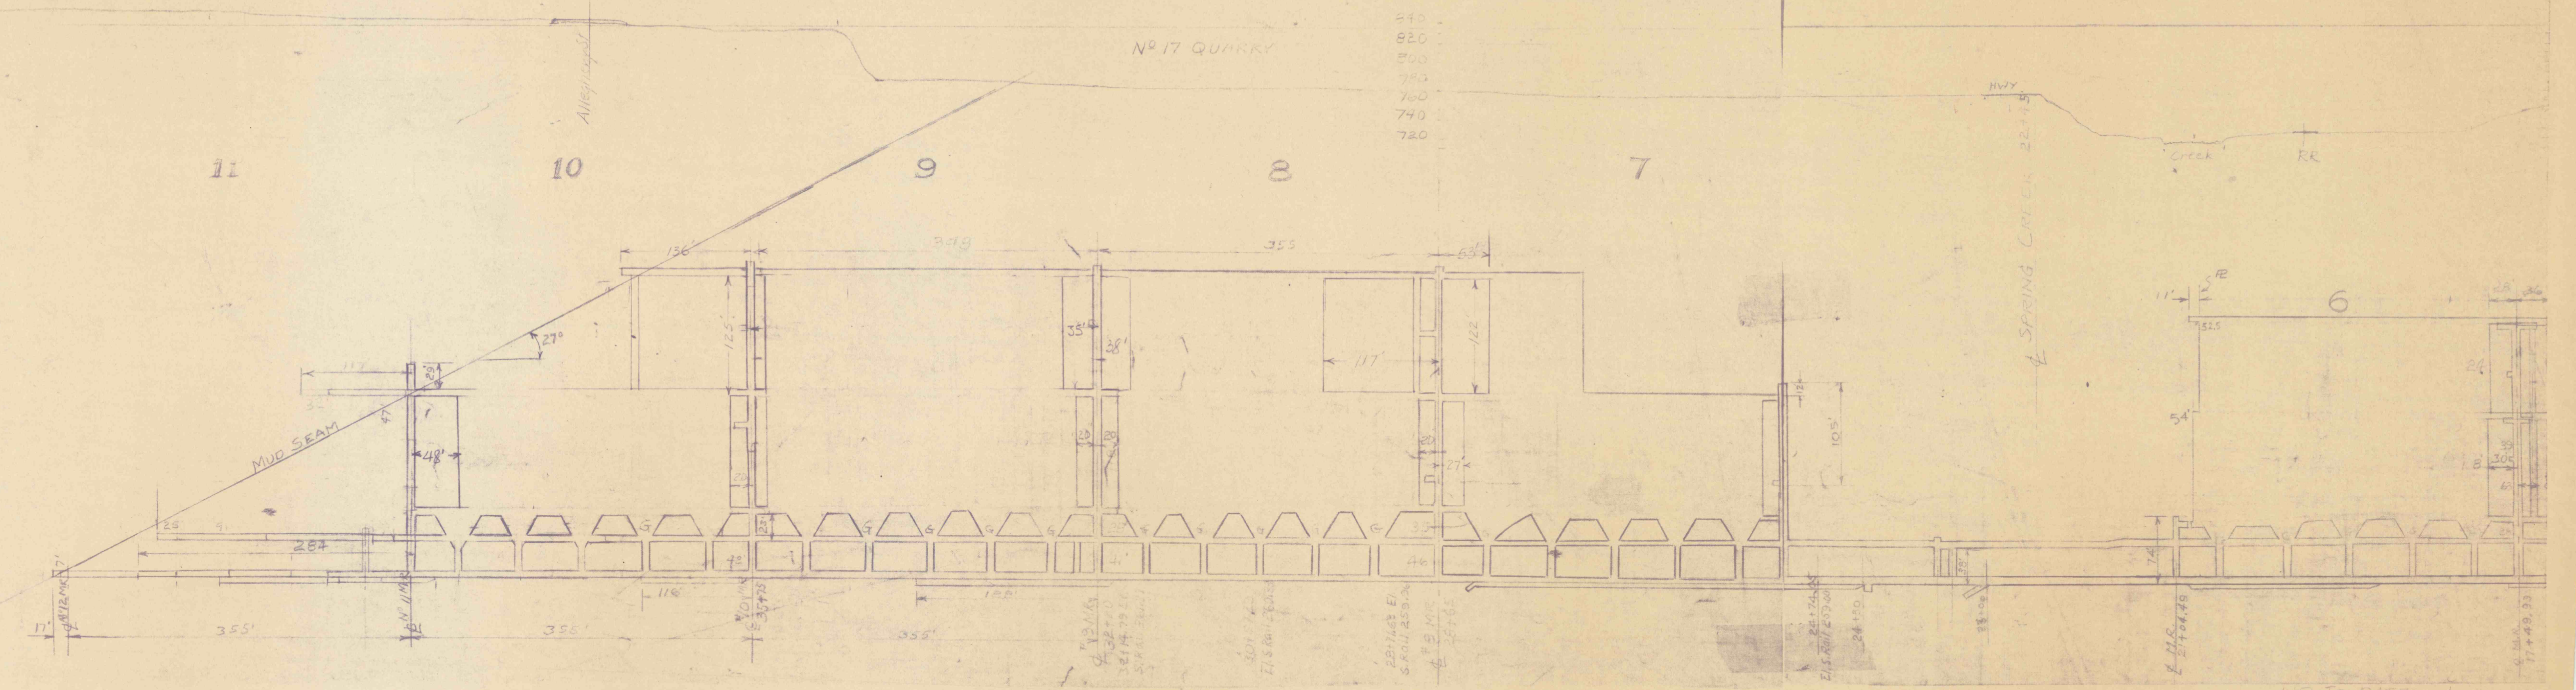

UP TO DATE July 1, 1961
JAN 1, 1968

speed #10

BELL MINE
EAST PROGRESS & DEVELOPMENT
 WARNER CO.
 BELLEFONTE PA.

DATE JAN. 6, 1953	DESIGN	DRAWN	TRACED	APPROVED	JOB NO.
			R.H.D.		0