


VICTOR No 24  
 PRO. BELT TO TIPPLE  
 1"=10' VER. & HOR.  
 7-13-53 M.B.  
 8-2-53 M.B.

VICTOR No 24  
 MAIN HDG (PRO. BELT)  
 1"=10' VER. & HOR.  
 7-13-53 M.L.B.  
 8-

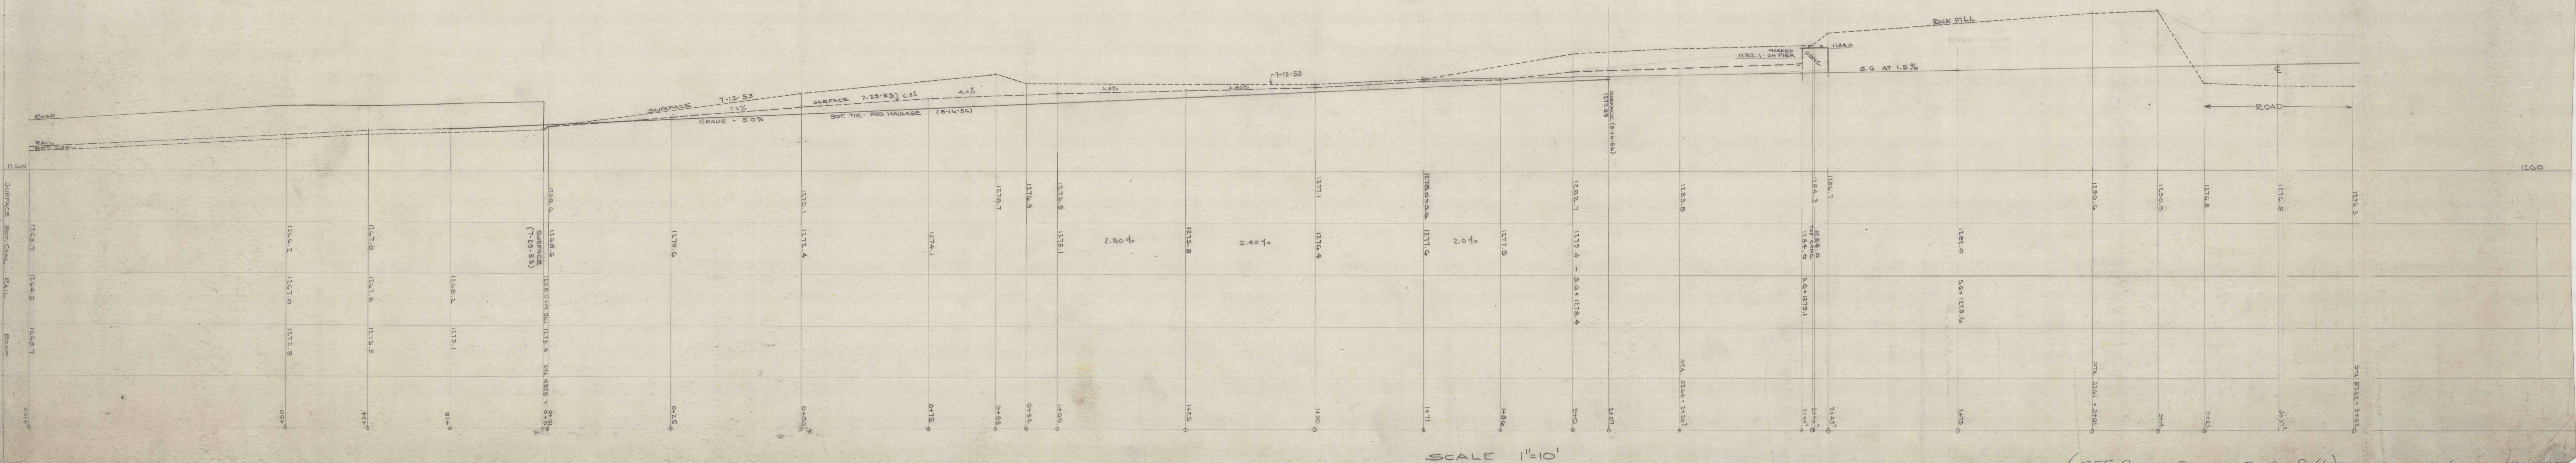

SCALE 1"=10'

(SEE PROFILE DRAWING FOR ADD. DATA) PRO. BELT & (VICTOR No 24)