TUNNELTON MINING CO.
MARION MINE
EXHIBIT No-1
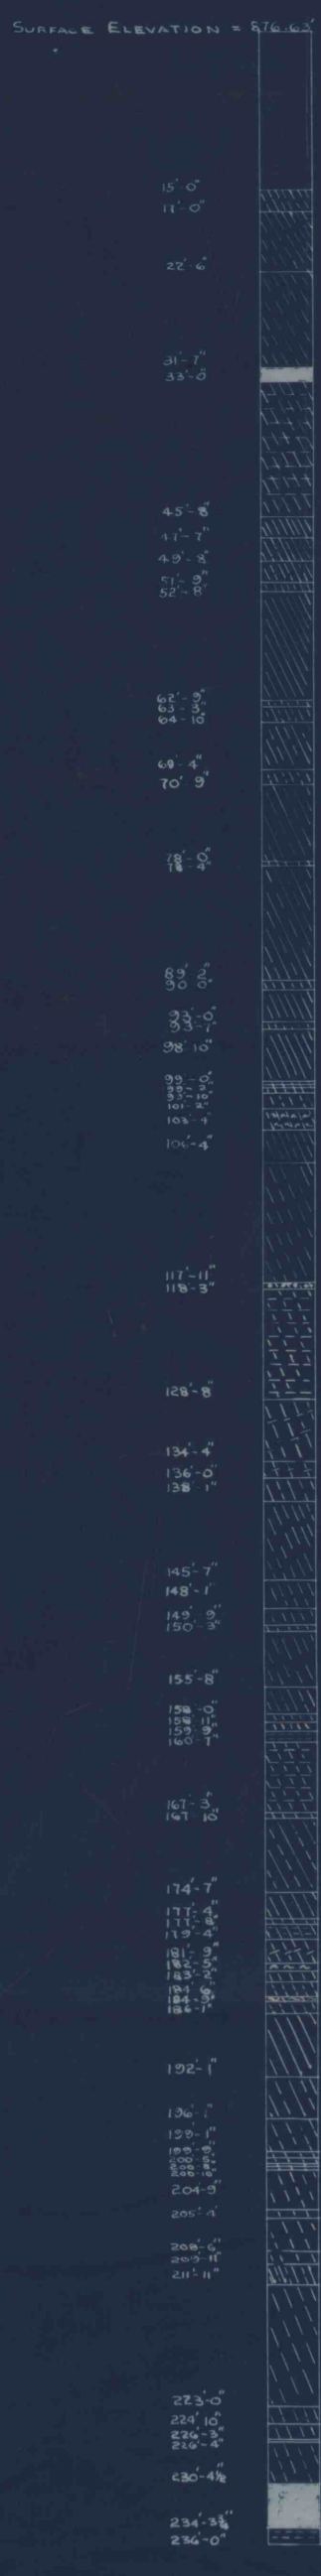
DIAMOND DRILL HOLE No 62-4
WEST PENN POWER CO. SURFACE
CONEMAUGH Twp. – INDIANA Co., PA.
SCALE 1 INCH = 10 FEET – JUNE 6, 1962
HICKS ENGINEERS – LEECHBURG, PA.