


KISKIMINETAS COAL CO.
 Roaring Run Operation
 Section of Vein - 48" to 56" Thick.

Scale - 1" = 2'

Albert Smith, C.E.,
 4/9/20 Saltzburg, Pa.

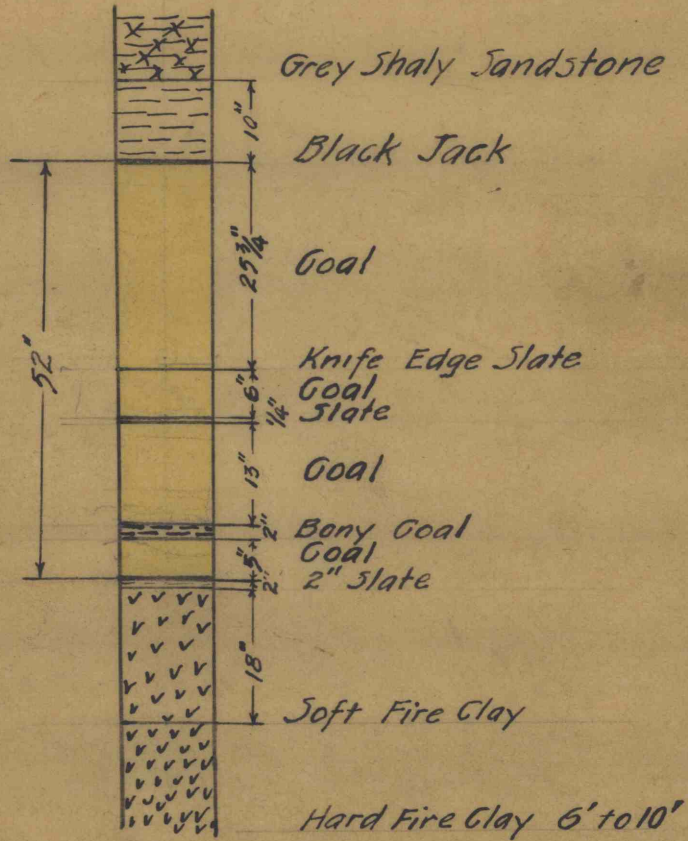

5605
~~RR. 2054~~

5605
 RR. 2054