1/8"-1'0" 0 1 2 4 6 8 10 12 14 16 | 1/4"-1'0" 0 1 2 3 4 5 6 7 8 9 10 | 1/2"-1'0" 0 1 2 3 4 5 | 3/4"-1'0" 0 1 2 3 | 1"-1'0" 0 1 2 3 | 1 1/2"-1'0" 0 1 2 | METRIC 1:100 SCALE 0 1 2 3 4 5 6 7 8 9 10 | METRIC 1:50 SCALE 0 1 2 3 4 5 6

BILL OF MATERIAL

NO. REQD.	NO. REQD.	MATERIAL	MARK	DESCRIPTION	REMARKS	EST. WGT.

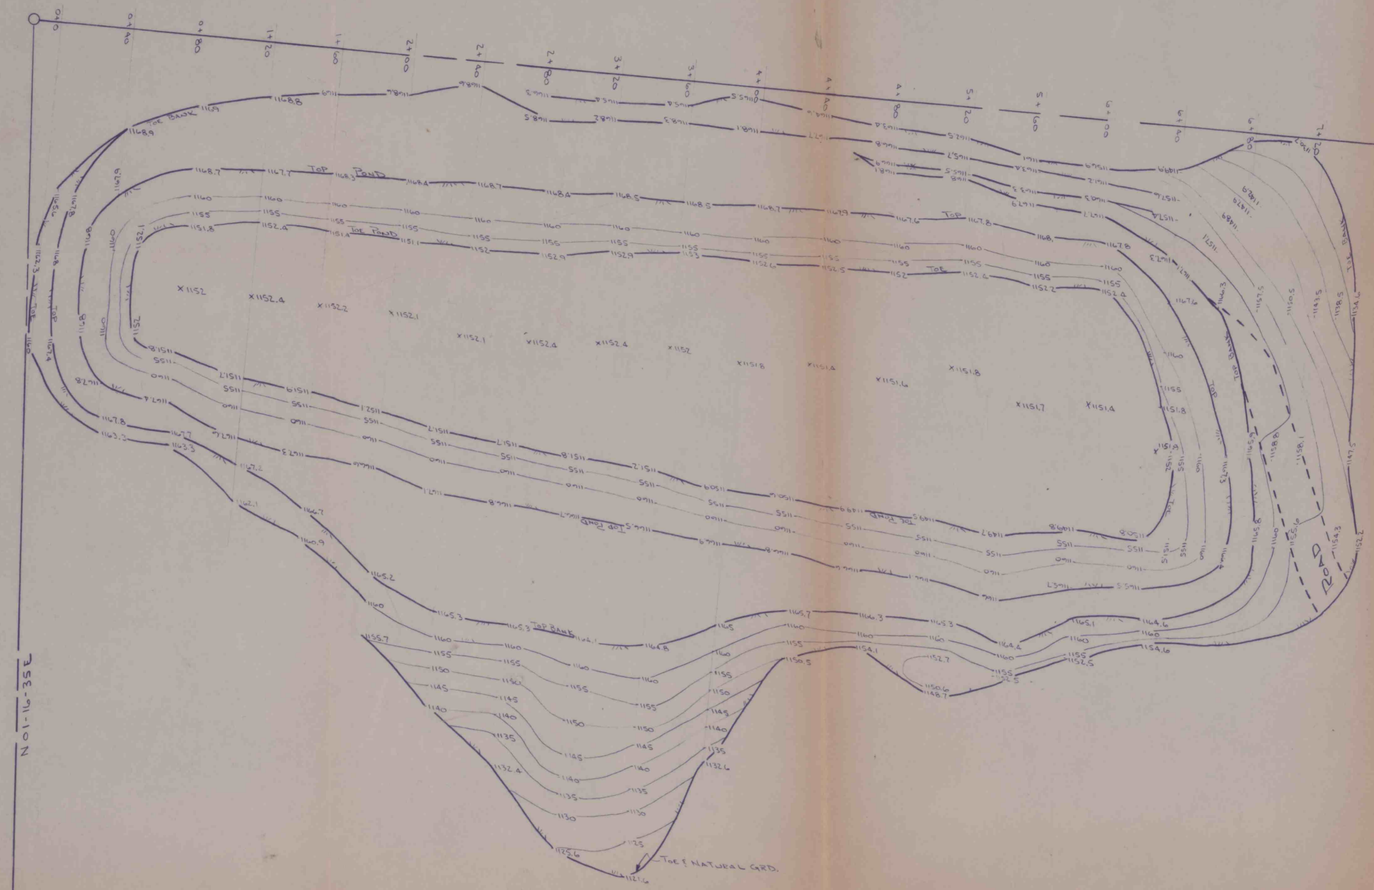

NO. REQD.	NO. REQD.	MATERIAL	MARK	DESCRIPTION	REMARKS	EST. WGT.

ENGINEERING DRAWING COMPUTER INPUT

DRAWING NUMBER ALPHA	NUMERIC	ISSUE	SEARCH ARGUMENT DIST.	CAT.	DEPT.	ITEM	DOC. TYPE
XA	1052		7	12	60	12	272

DRAWING TITLE — SEED NO. 79

FINAL X-SECTIONS/WILBERT 05

REFERENCE OR DRAWINGS: CONSTRUCTION DWG'S XA-1052 & XA-1052-1

NOTES BK 70 Pg 2 To 6

THIS DRAWING IS LOANED WITH THE EXPRESSED AGREEMENT THAT THE DRAWING AND INFORMATION THEREIN CONTAINED ARE THE PROPERTY OF REPUBLIC STEEL CORPORATION AND WILL NOT BE REPRODUCED, COPIED, OR OTHERWISE DISPOSED OF DIRECTLY OR INDIRECTLY, AND WILL NOT BE USED IN WHOLE OR IN PART TO ASSIST IN MAKING OR TO FURNISH ANY INFORMATION FOR THE MAKING OF DRAWINGS, PRINTS OR OTHER REPRODUCTIONS HEREOF, OR FOR THE MAKING OF APPARATUS OR PARTS THEREOF, EXCEPT UPON WRITTEN PERMISSION OF REPUBLIC STEEL CORPORATION FIRST OBTAINED AND SPECIFIC AS TO EACH CASE. THE ACCEPTANCE OF THIS DRAWING WILL BE CONSTRUED AS AN ACCEPTANCE OF THE FOREGOING AGREEMENT.

DEPT. APPROVED	REVISION DESCRIPTION
OPER.	
DATE	
MECH.	
DATE	
ELECT.	
DATE	
ENGR.	
DATE	

ISSUE OR REVISION No.	DATE	BY
1		
2		
3		
4		
5		
6		
7		
8		
9		
10		

Republic steel

DISTRICT/DIVISION BCNR Mining PLANT/WORKS Russelton Mine

DEPARTMENT Engineering

ITEM Wilbert Water Treatment Pond
Final X-Sections

SCALE 1" = 40'

DRAWN JD DATE 6-7-82

CHECKED DATE

CHECKED SAFETY DATE

APPROVED DATE

XA-1052-5

ENG-662 Rev 2-79

RECEIVED
JAN 06 1988
Dept. of Environmental Resources
McMurray District Office