


N 23 QUARRY

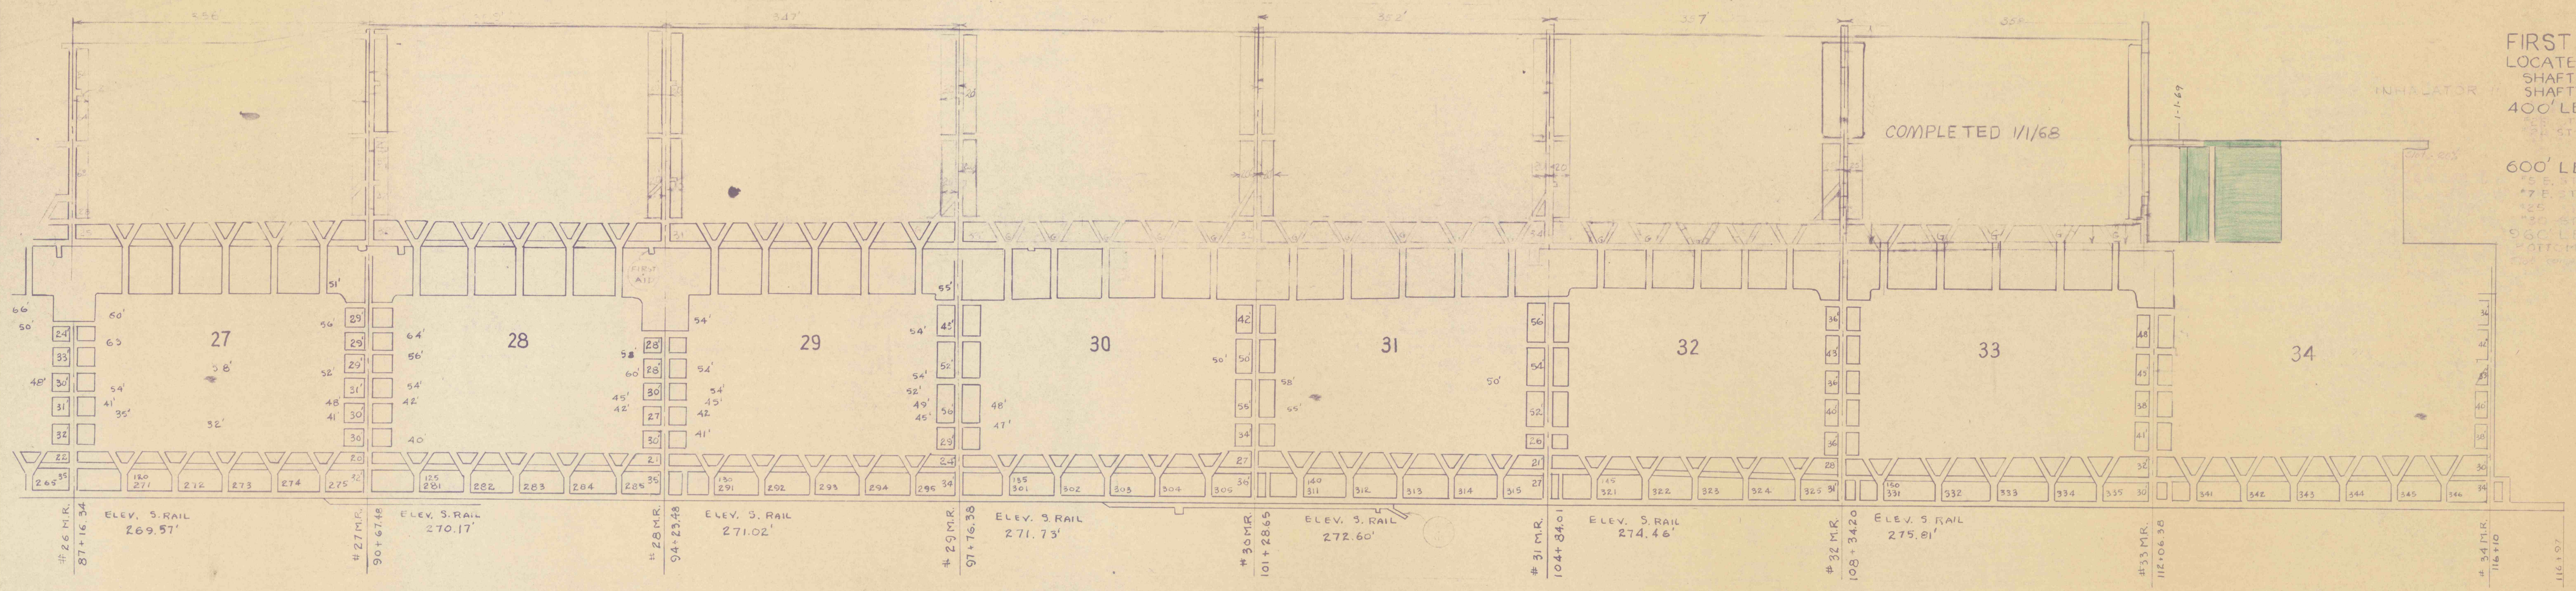

COMPLETED 1/1/68

FIRST AID STA  
 LOCATED AT  
 SHAFT #1 DRY HOUSE  
 SHAFT #2 DRY HOUSE  
 400' LEVEL  
 22 ST. PE

600' LEVEL  
 7 ST. PE  
 25 ST. PE  
 900' LEVEL  
 BOTTOM BELLOWS SLOPE

INHALATOR

PROPERTY LINE

ELEV. Mt. Gnr. Dr. 1.1.69 701.50'

speed # 11