
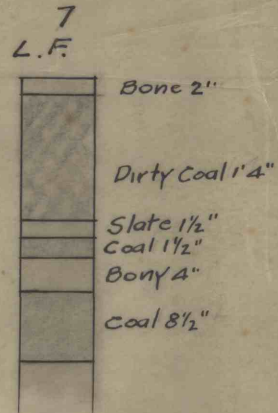
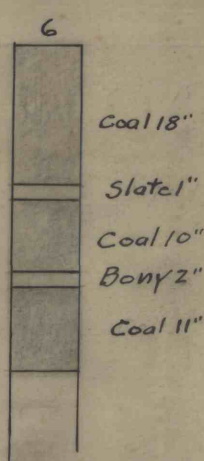
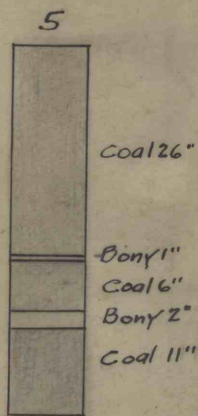
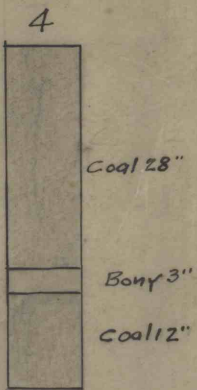
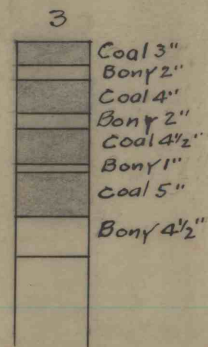
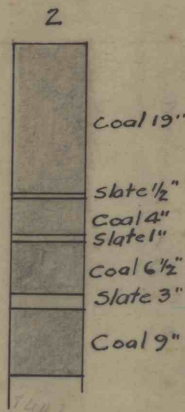
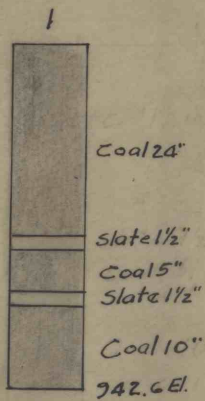


GRAFF COAL CO. COAL SECTIONS

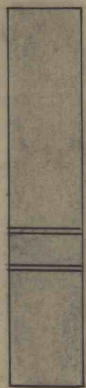

L.H. 4004

L.H. 4046