


PLAN SHOWING
 FRANK ANGELO PIT
 SUMNER N^o2 MINE OF
 PITTSBURGH & ERIE COAL CO.
 Jefferson Twp., Fayette Co., Pa.
 Scale 1" = 10' Mar. 8, 1947.

Tinted Red - Coal Mined by Frank Angelo.
 Tinted Green - Posts for Roof Support.

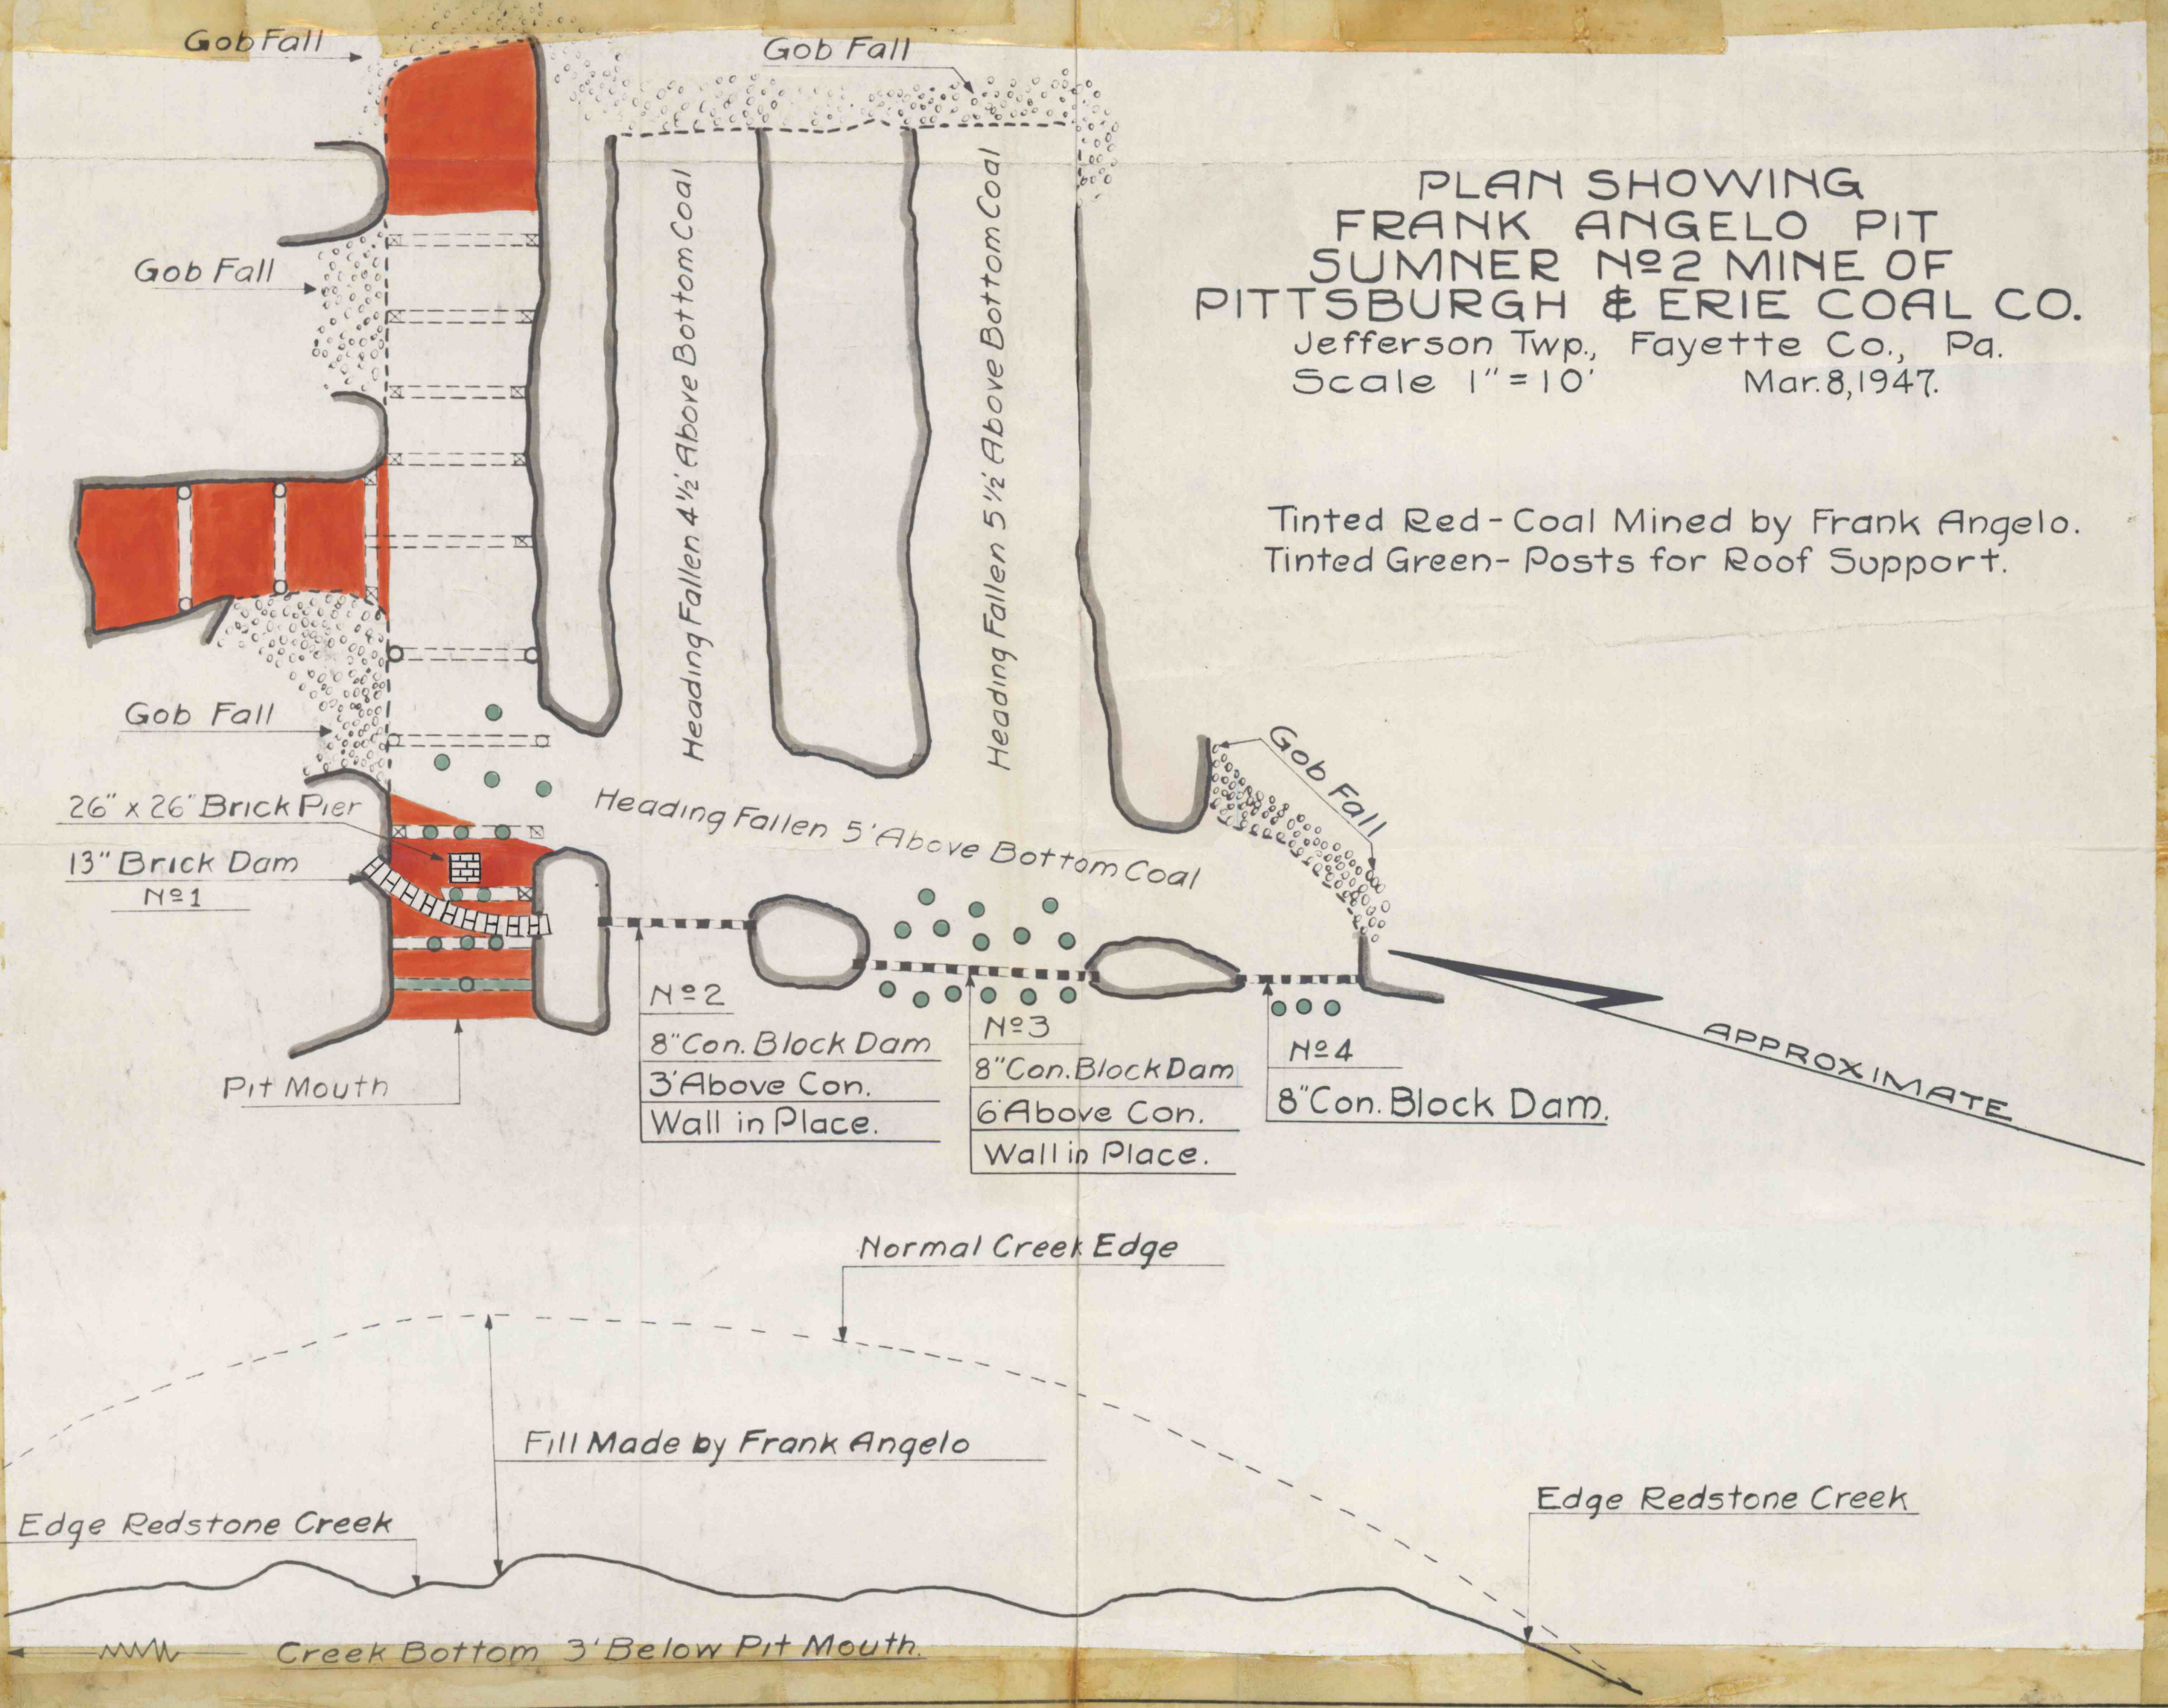

APPROXIMATE

