



ATTACHMENT 5

PIT MOUTH DIMENSIONS

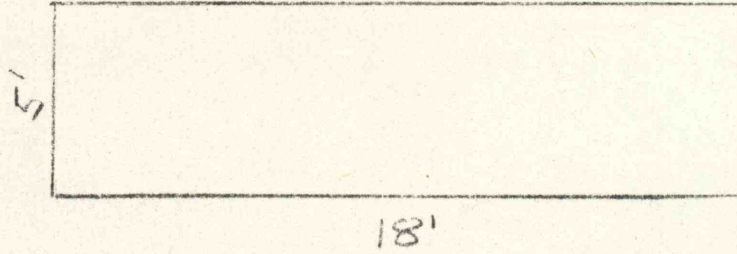

PORTAL OPENING #1 - FORMER TRACK ENTRY

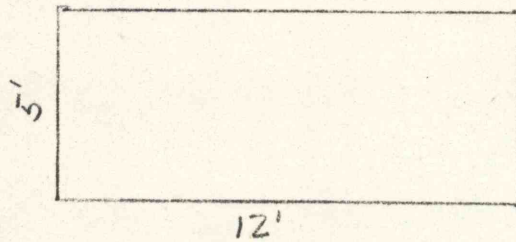

PORTAL OPENING #2 - FORMER BELT ENTRY