


Exhibit B

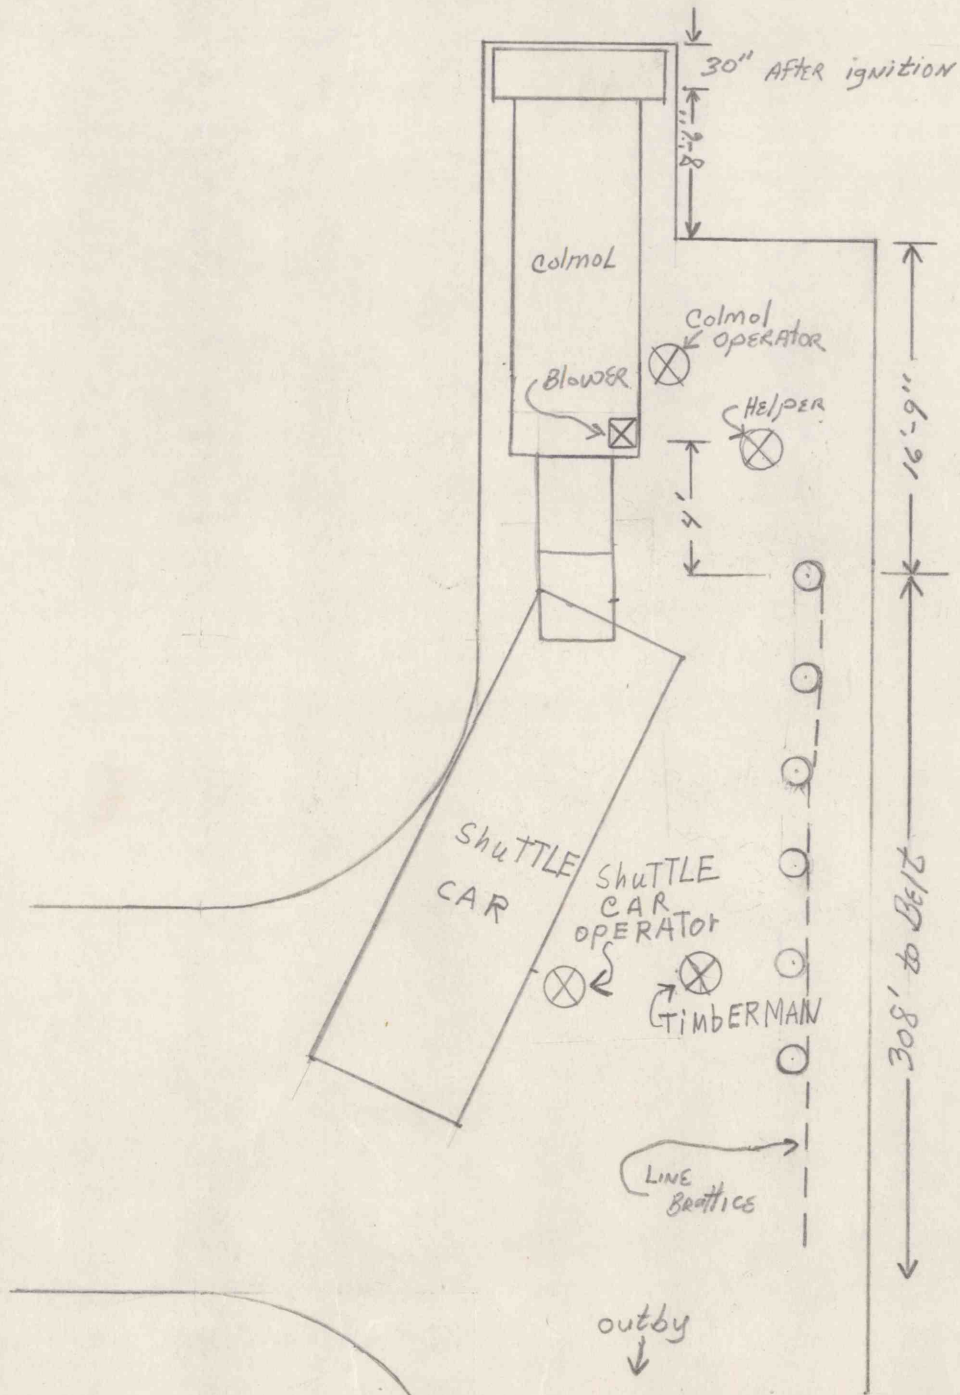

BARNES & TUCKER Co.
LANCASTHIRE #15
A-8 heading - #7 ROOM
IGNITION AREA
SCALE: 1" = 10'
9/27/67