


EXHIBIT A  
 FATAL ACCIDENT OF WAYNE JONES  
 BARNES & TUCKER COMPANY  
 LANCASHIRE NO. 24 B MINE  
 TK-10 SECTION  
 JANUARY 21, 1971    SCALE: 1" = 1'

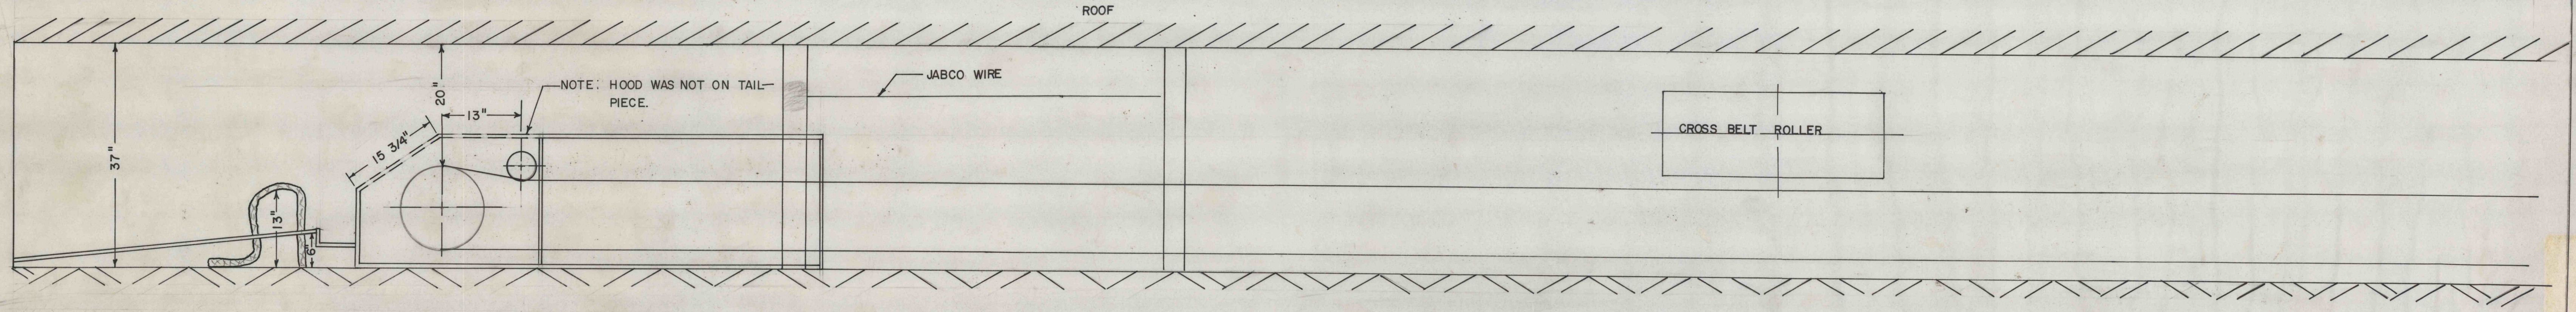

K-50-50