


shape of side on present casting $\frac{5}{8}$ " thick straight sides will do and $\frac{3}{4}$ " thick would give more strength

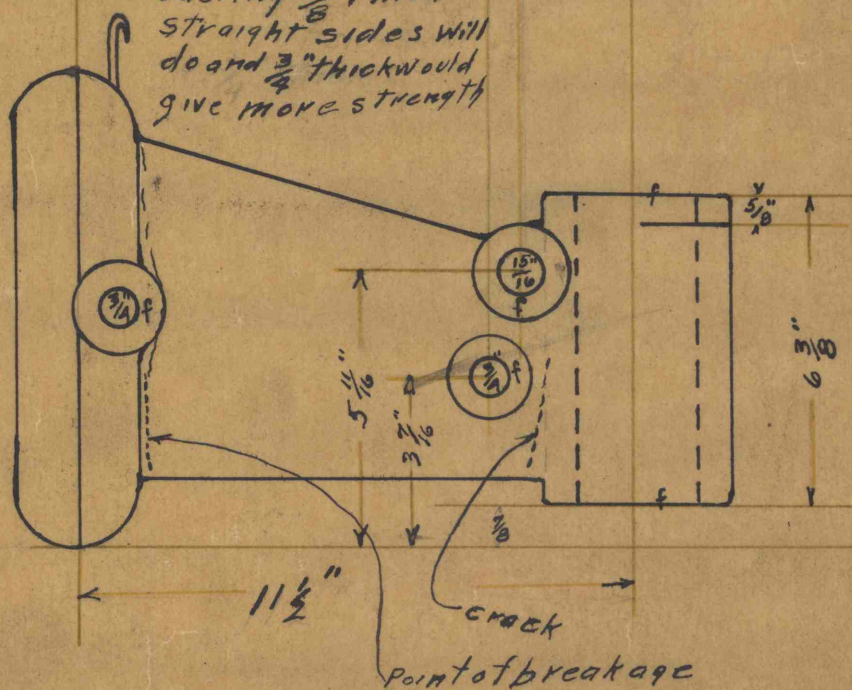

SKETCH
of
Arm for Drill Press
WESTMORELAND MINING CO.
Blairsville Pa.
Scale 3" = 12" 2/14/21 Albert Smith C.E.
Blairsville Pa.