
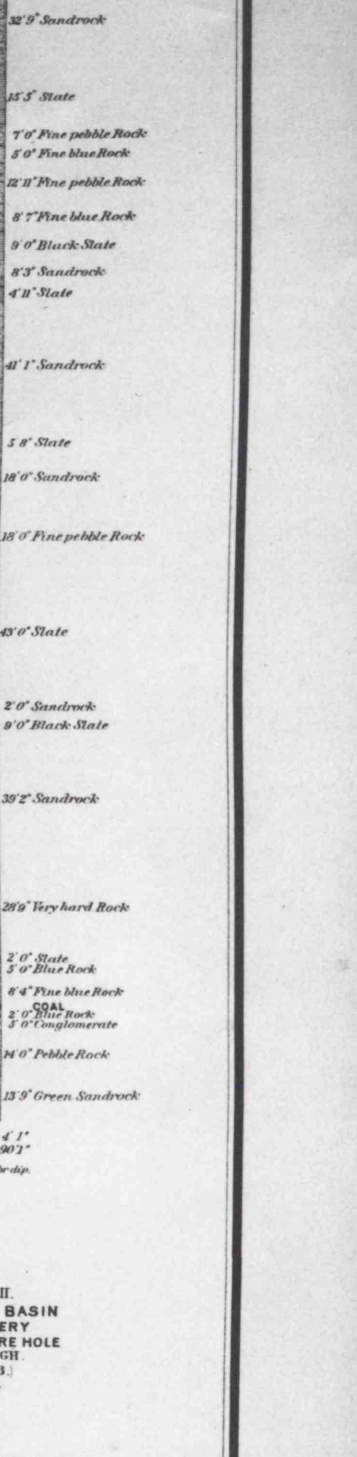
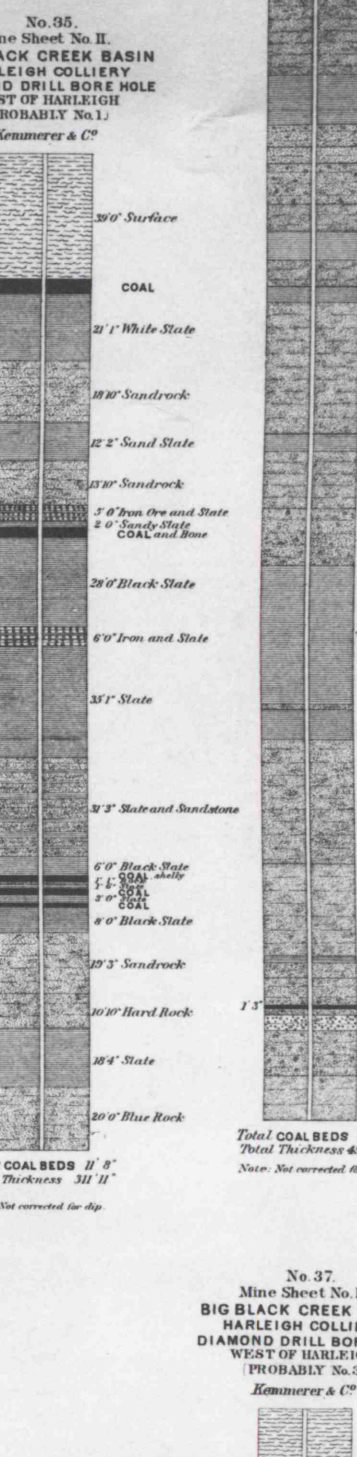
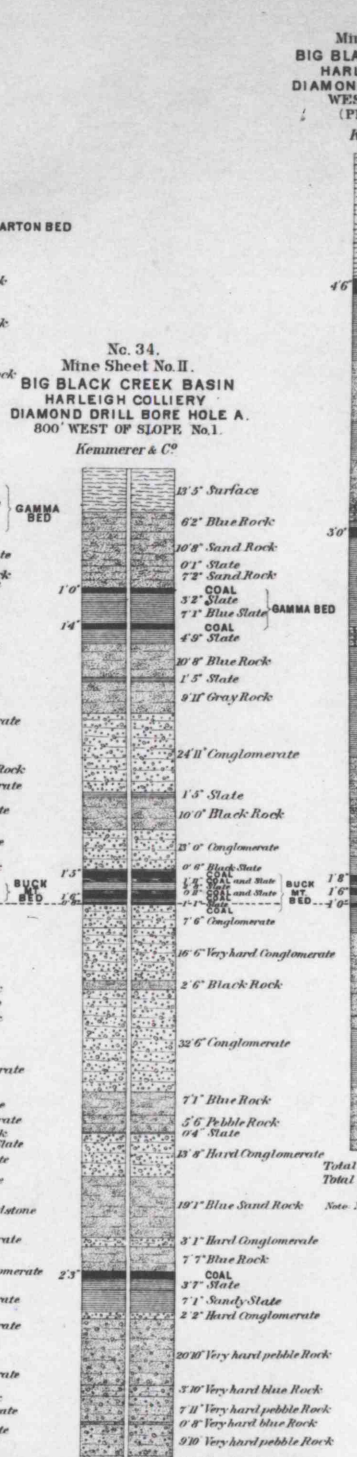
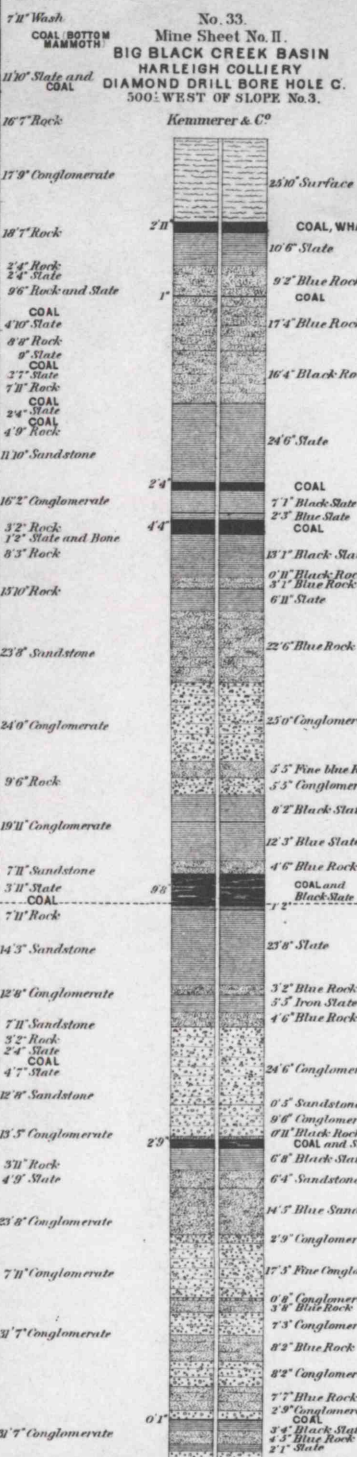
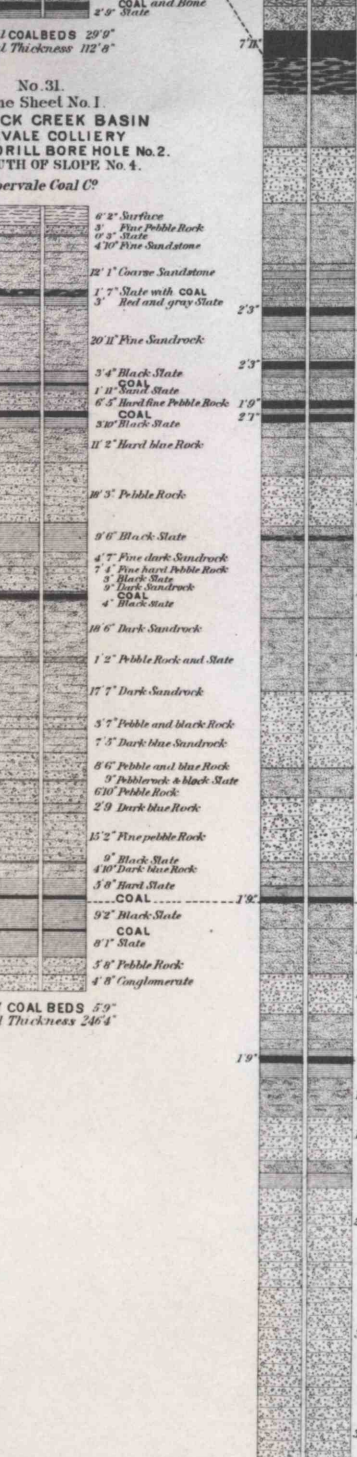
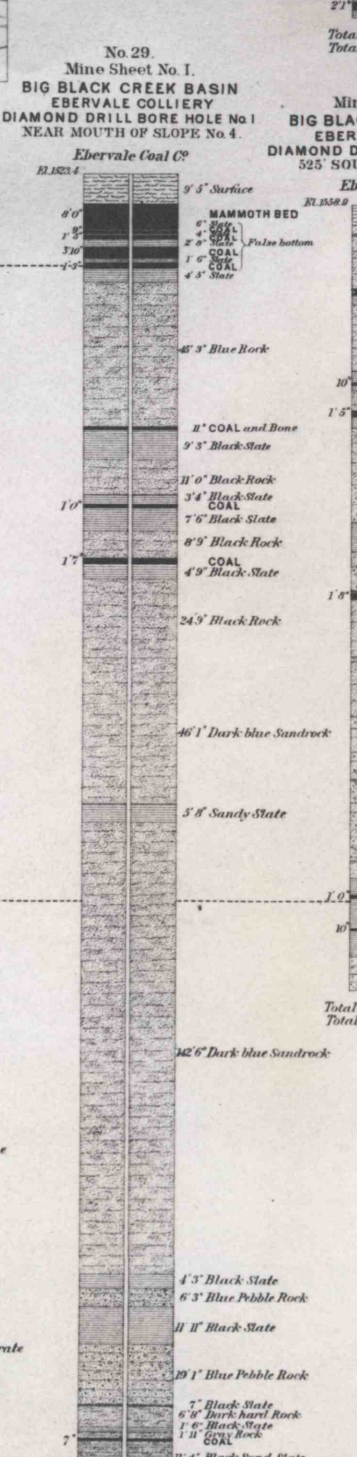
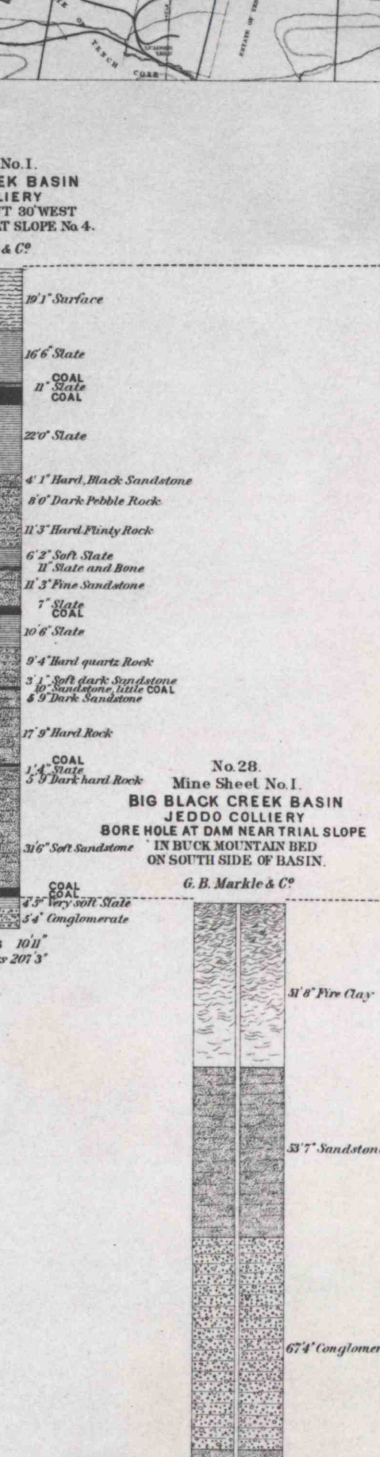
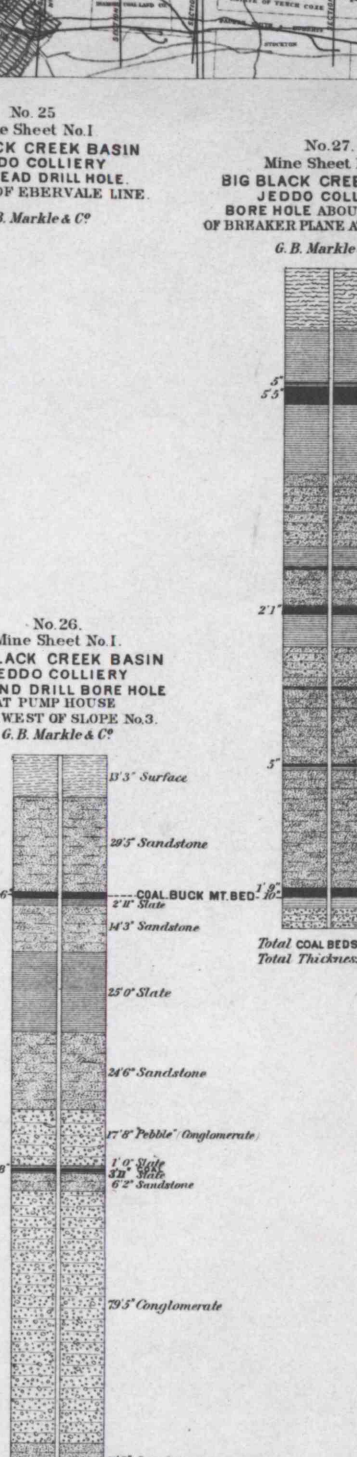
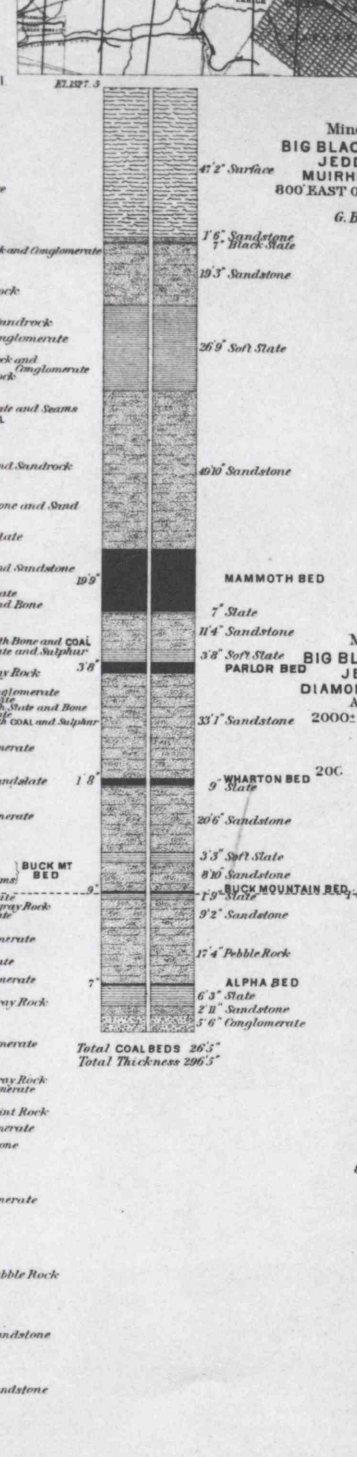
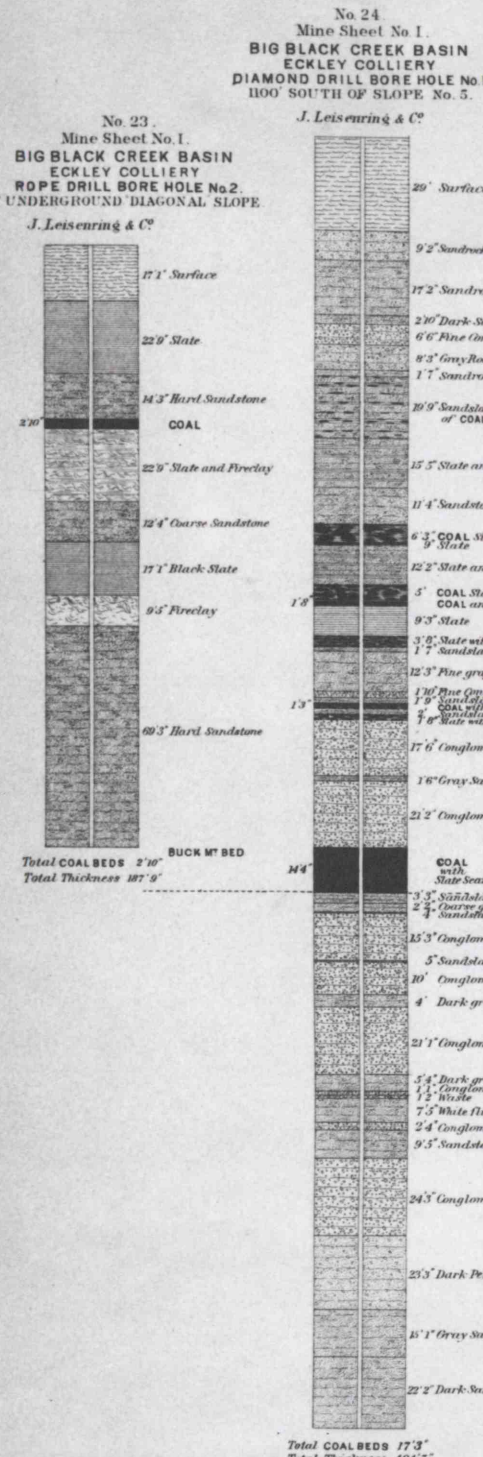











SKELETON MAP OF MINE SHEETS NOS. I AND II SHOWING THE POSITION OF THE COLUMNAR SECTIONS

Note: For additional columnar sections within the area embraced by Mine Sheets Nos. I and II, see Columnar Section Sheets I and II.

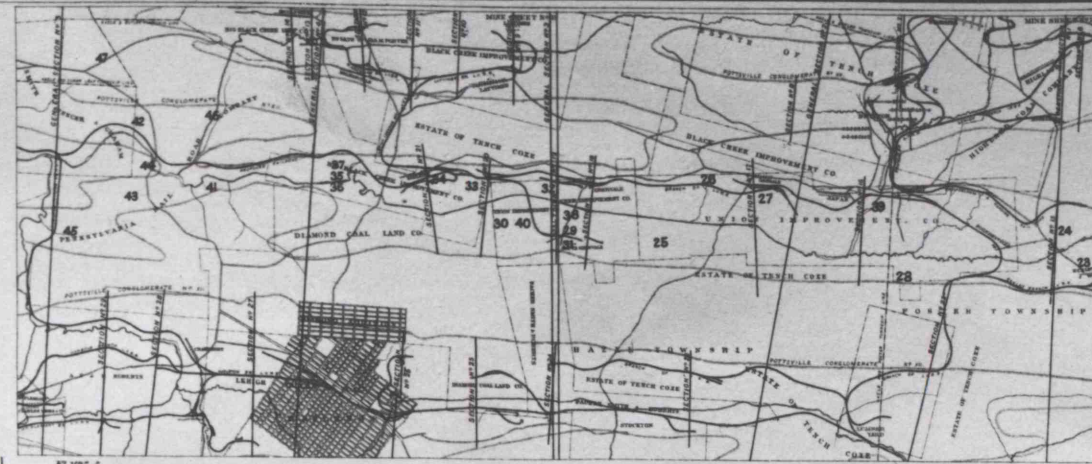

COLUMNAR SECTIONS OF THE COAL MEASURES IN THE VICINITY OF ECKLEY, JEDDO, EBBERVALE, HARLEIGH AND HAZLETON, LUZERNE COUNTY. CONSTRUCTED FROM MEASUREMENTS OBTAINED FROM THE COMPANIES NAMED IN THE INDIVIDUAL TITLES.

Scale of General Sections, 40 feet to 1 inch. Scale of Coal Measure Sections, 10 feet to 1 inch.

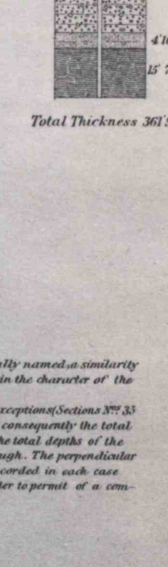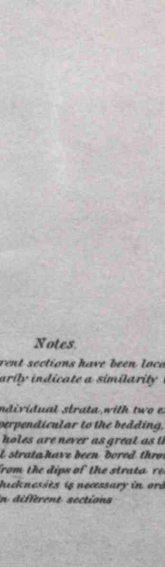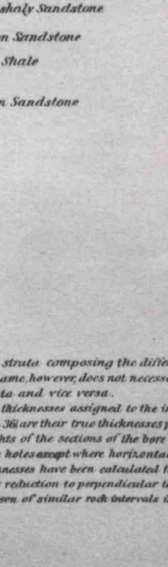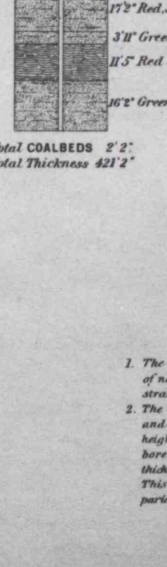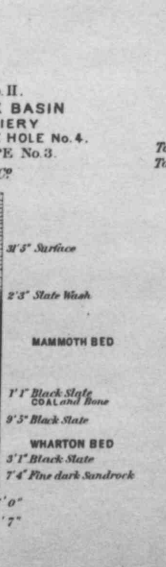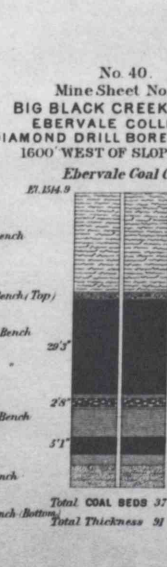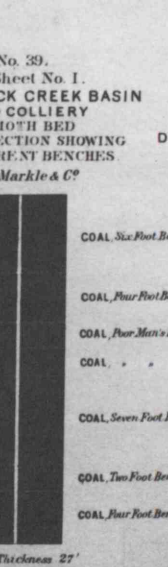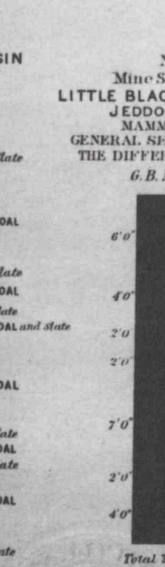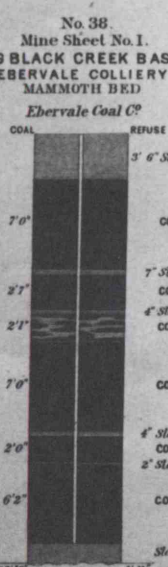

Notes:
1. The strata composing the different sections have been locally named, a similarity of name however does not necessarily indicate a similarity in the character of the strata and vice versa.
The perpendicular thickness has been indicated from the dip of the strata recorded in each case. This reduction to perpendicular thickness is necessary in order to permit of a comparison of similar rock intervals in different sections.