

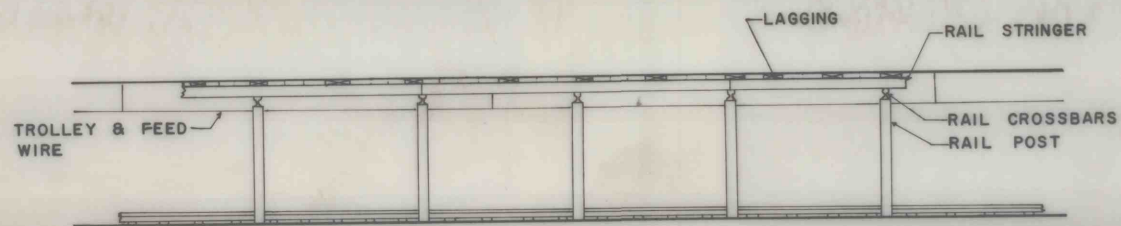


BEFORE

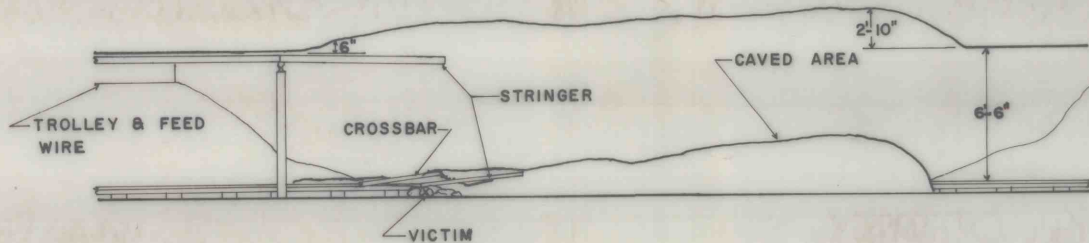

AFTER

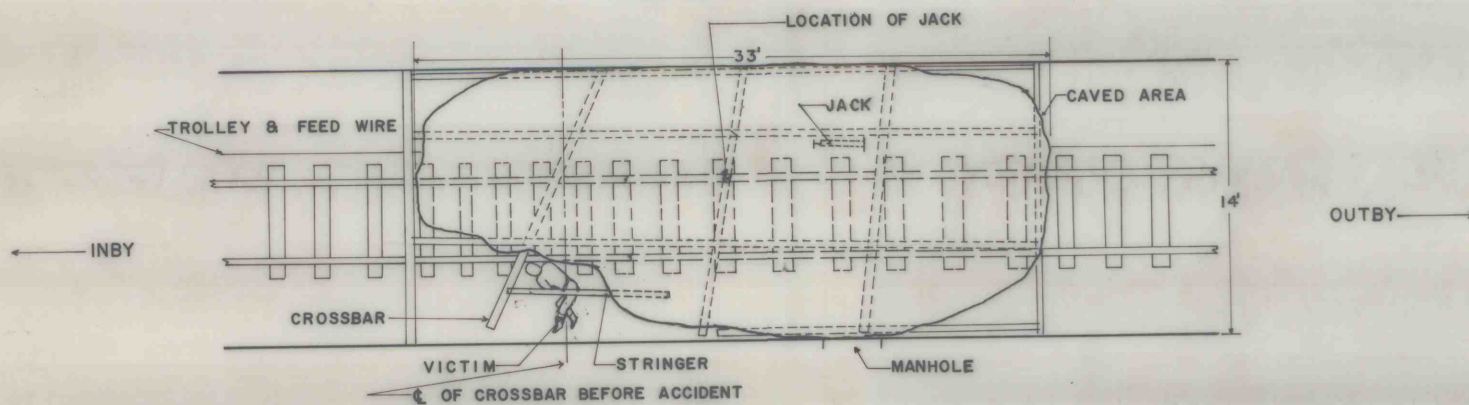

BARNES & TUCKER CO.
LANCASHIRE NO. 15
FATAL ACCIDENT OF
JOHN CLIPPER
SEPTEMBER 8, 1965
SCALE: 1" = 5'