

EXHIBIT NO. 4

SECTION OF
 COMMERCIAL COAL CO. #16 SLOPE
 VINTON COLLIERY CO.
 VINTONDALE, PENNA.
 SCALE $\frac{1}{32}$ IN. = 1 FT. MAY 26 1932

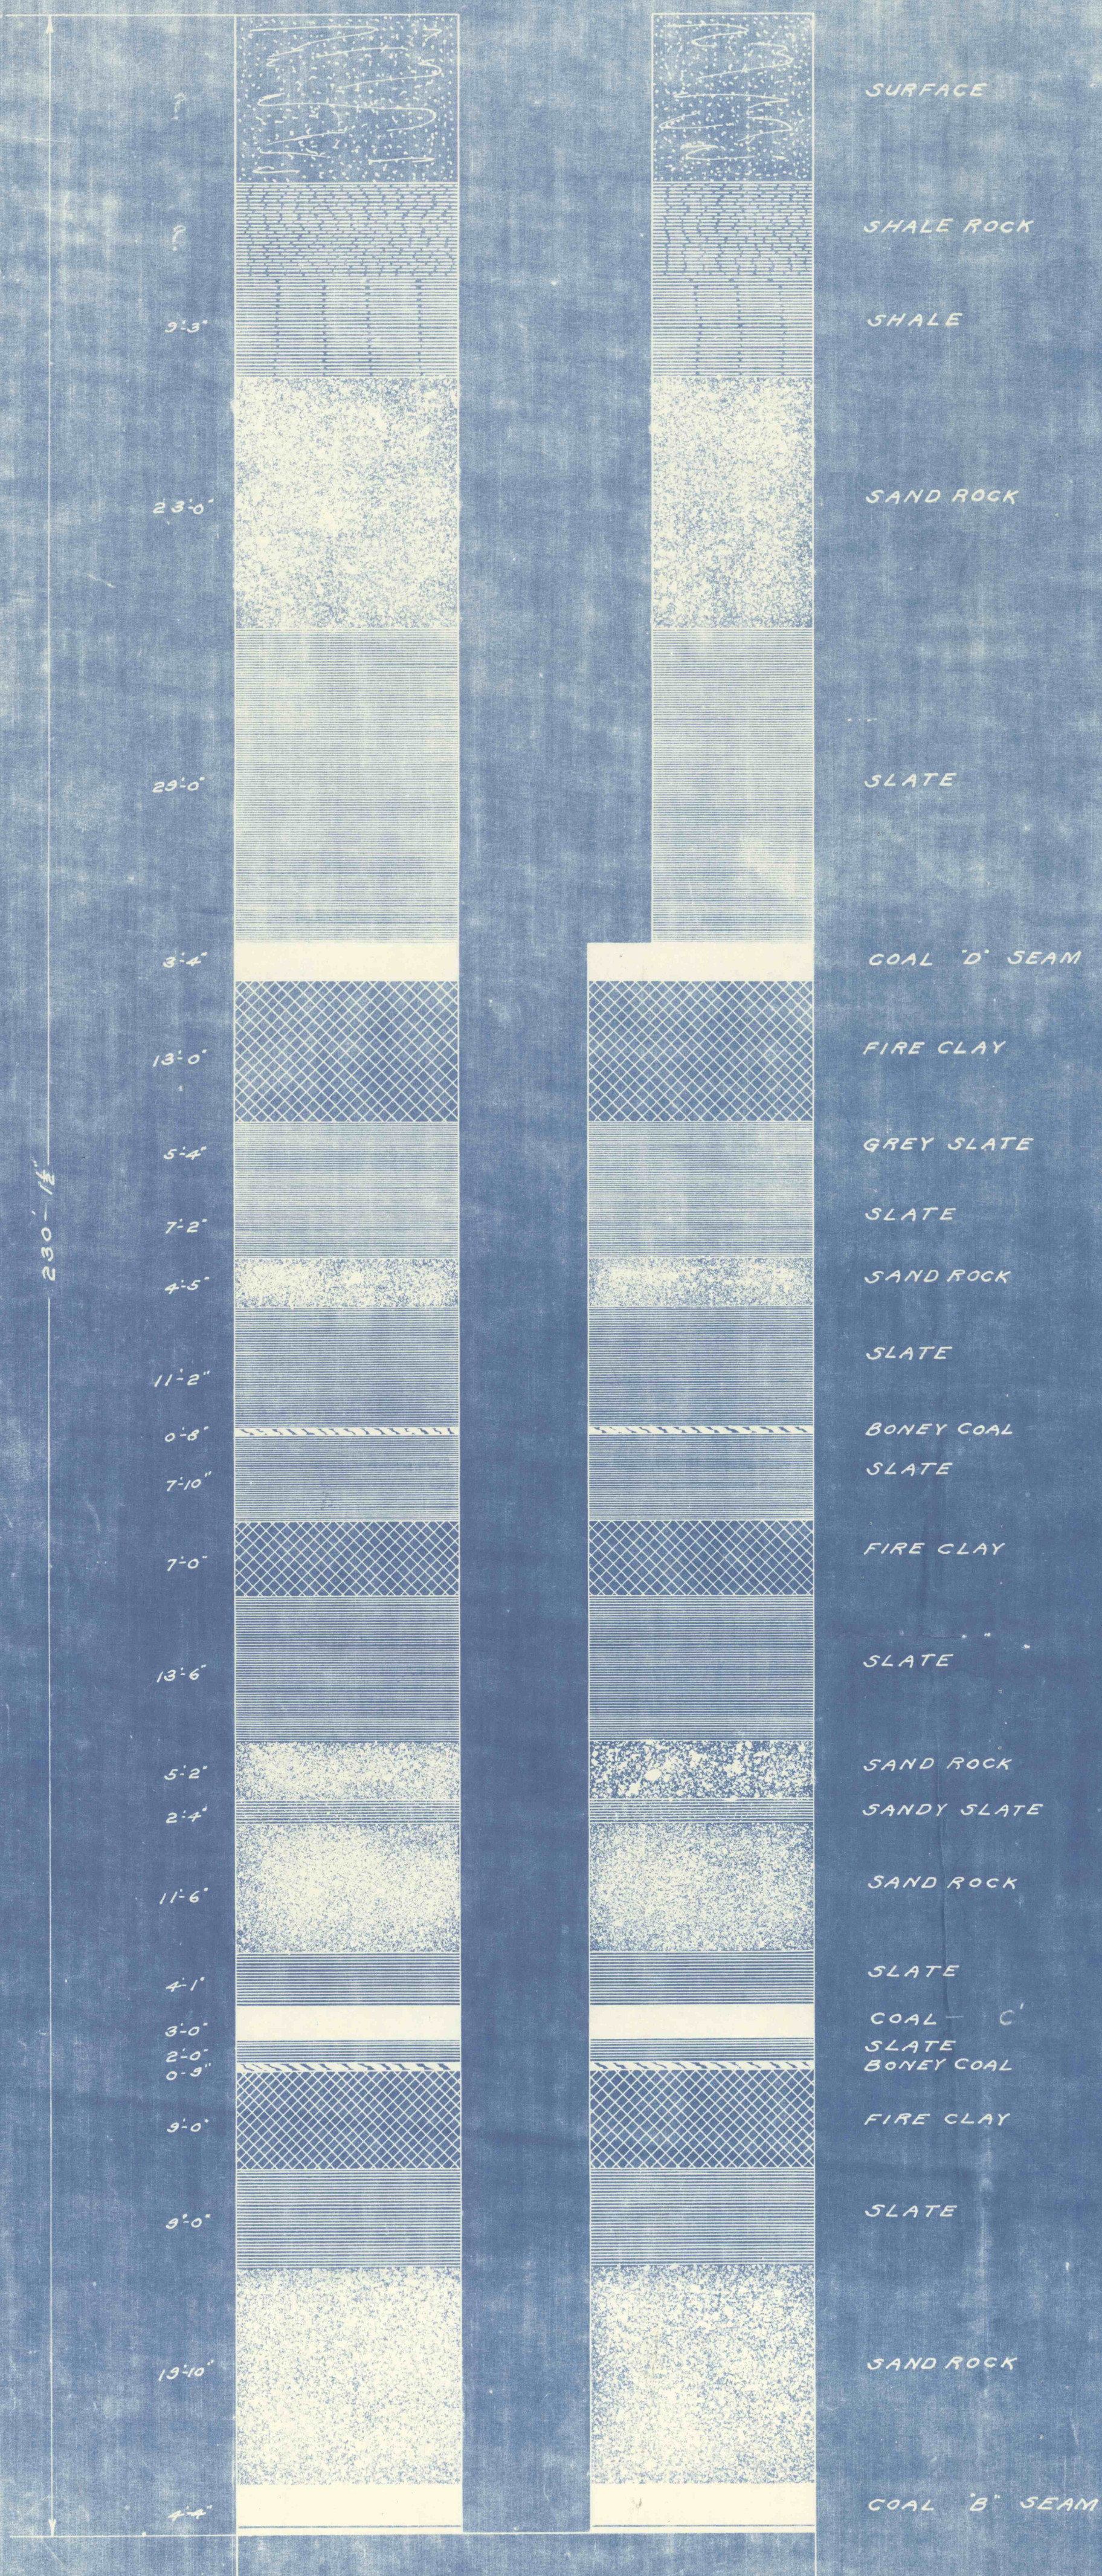


EXHIBIT NO. 4