


211-11-1001
 BUREAU FILE 1009
 NORTH BRANCH BIRMINGHAM GEOL
 RECORDING IN 1705 FINISHED 11-2-08
 2593 W3975

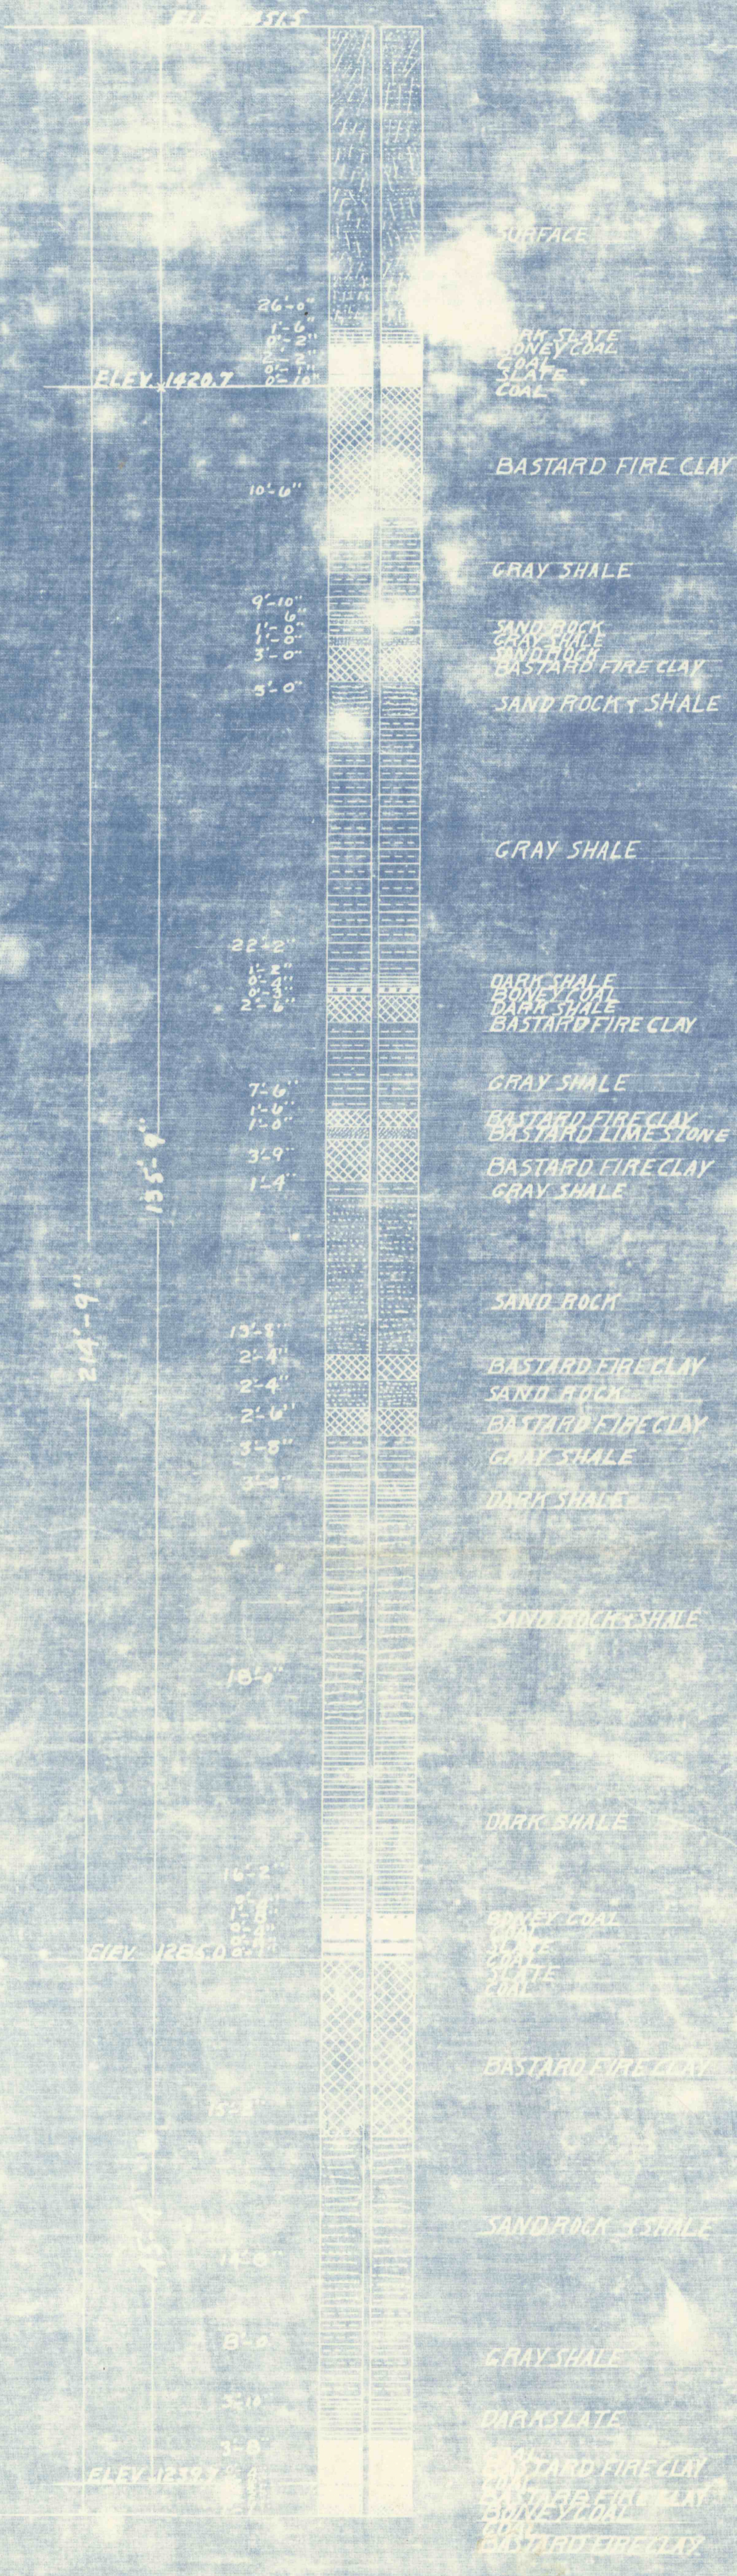

ANALYSIS

VOLATILE MATTER	16.31
FIXED CARBON	76.91
ASH	16.65
WATER	2.17