


**EXHIBIT NO. 1**

BORE HOLE NO. 9

NORTH BRANCH BLACKLICK CREEK

BEGAN DRILLING 10-17-08 FINISHED 10-24-08

N 45° 95' W 3975

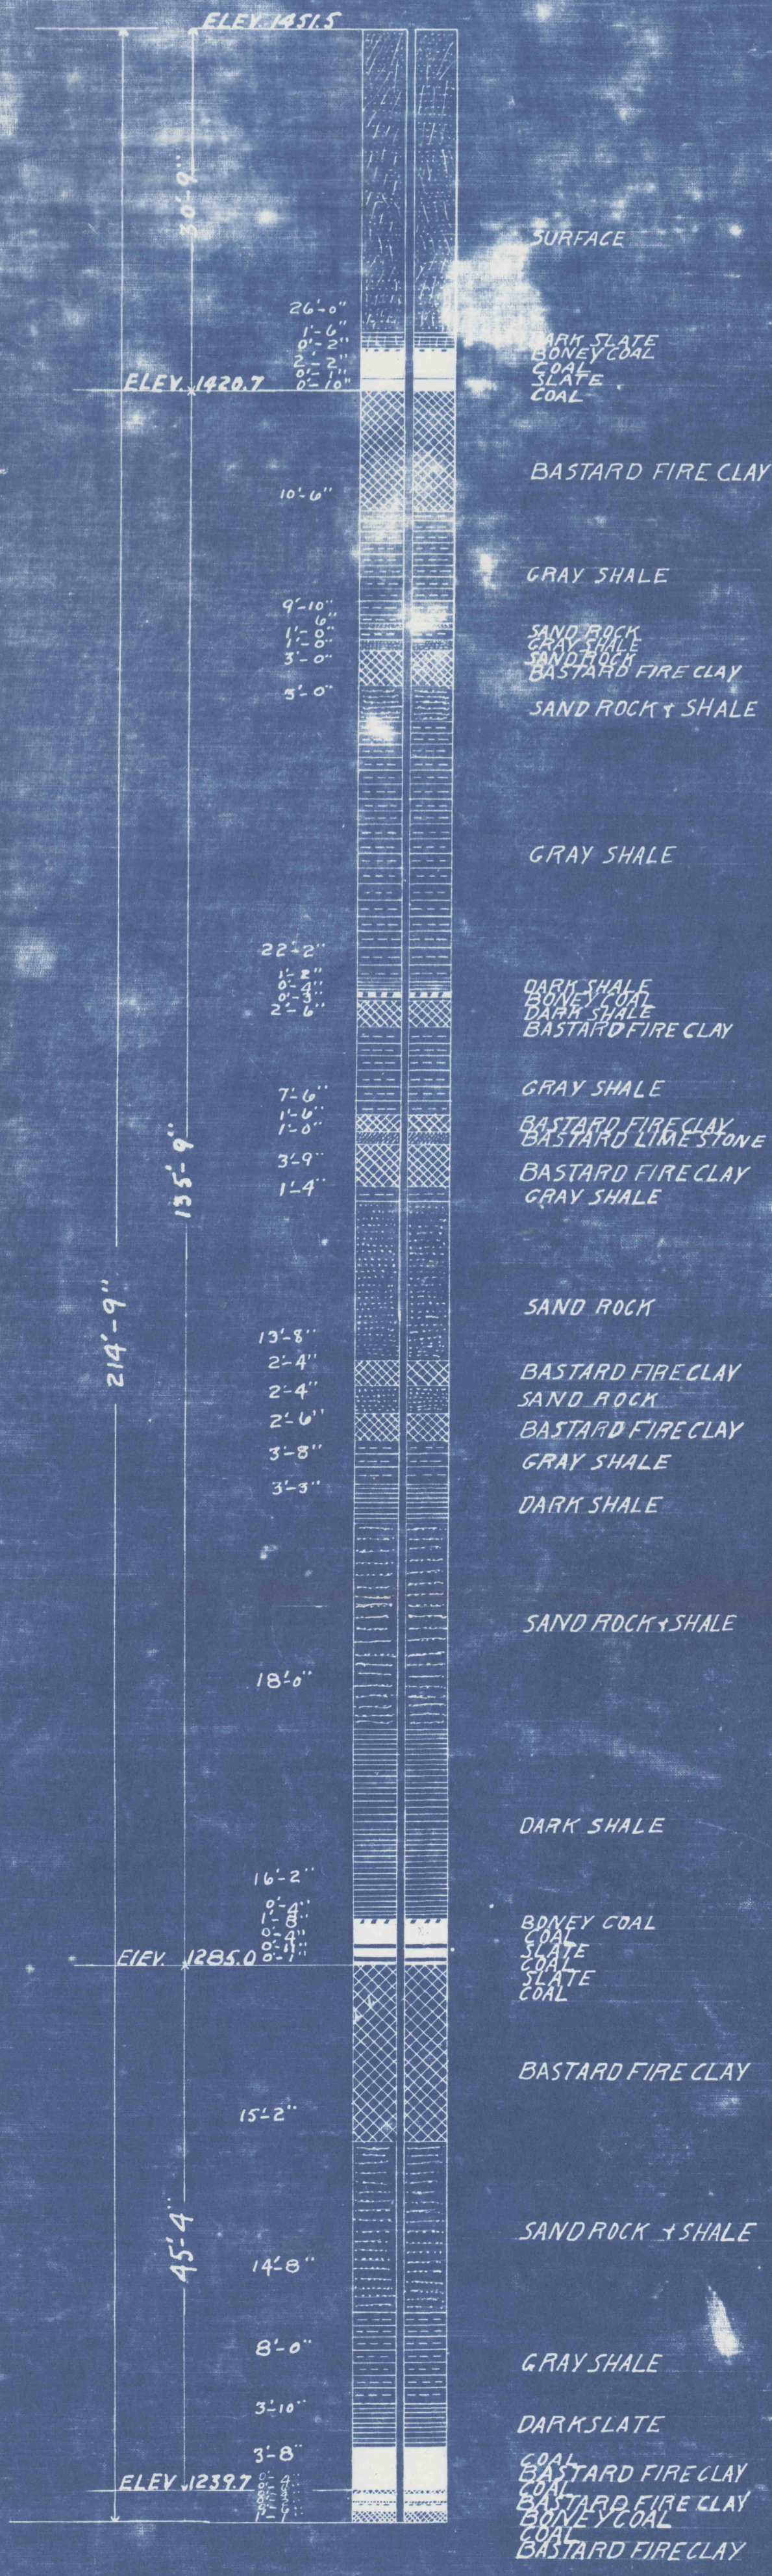

**ANALYSIS**

VOLATILE MATTER	18.41
FIXED CARBON	74.91
ASH	6.68
SULPHUR	2.57