D- 1448Z D-1466.4' D-1876.4'

HEILWOOD AREA

DEEP HOLES

1" = 10' VERT.
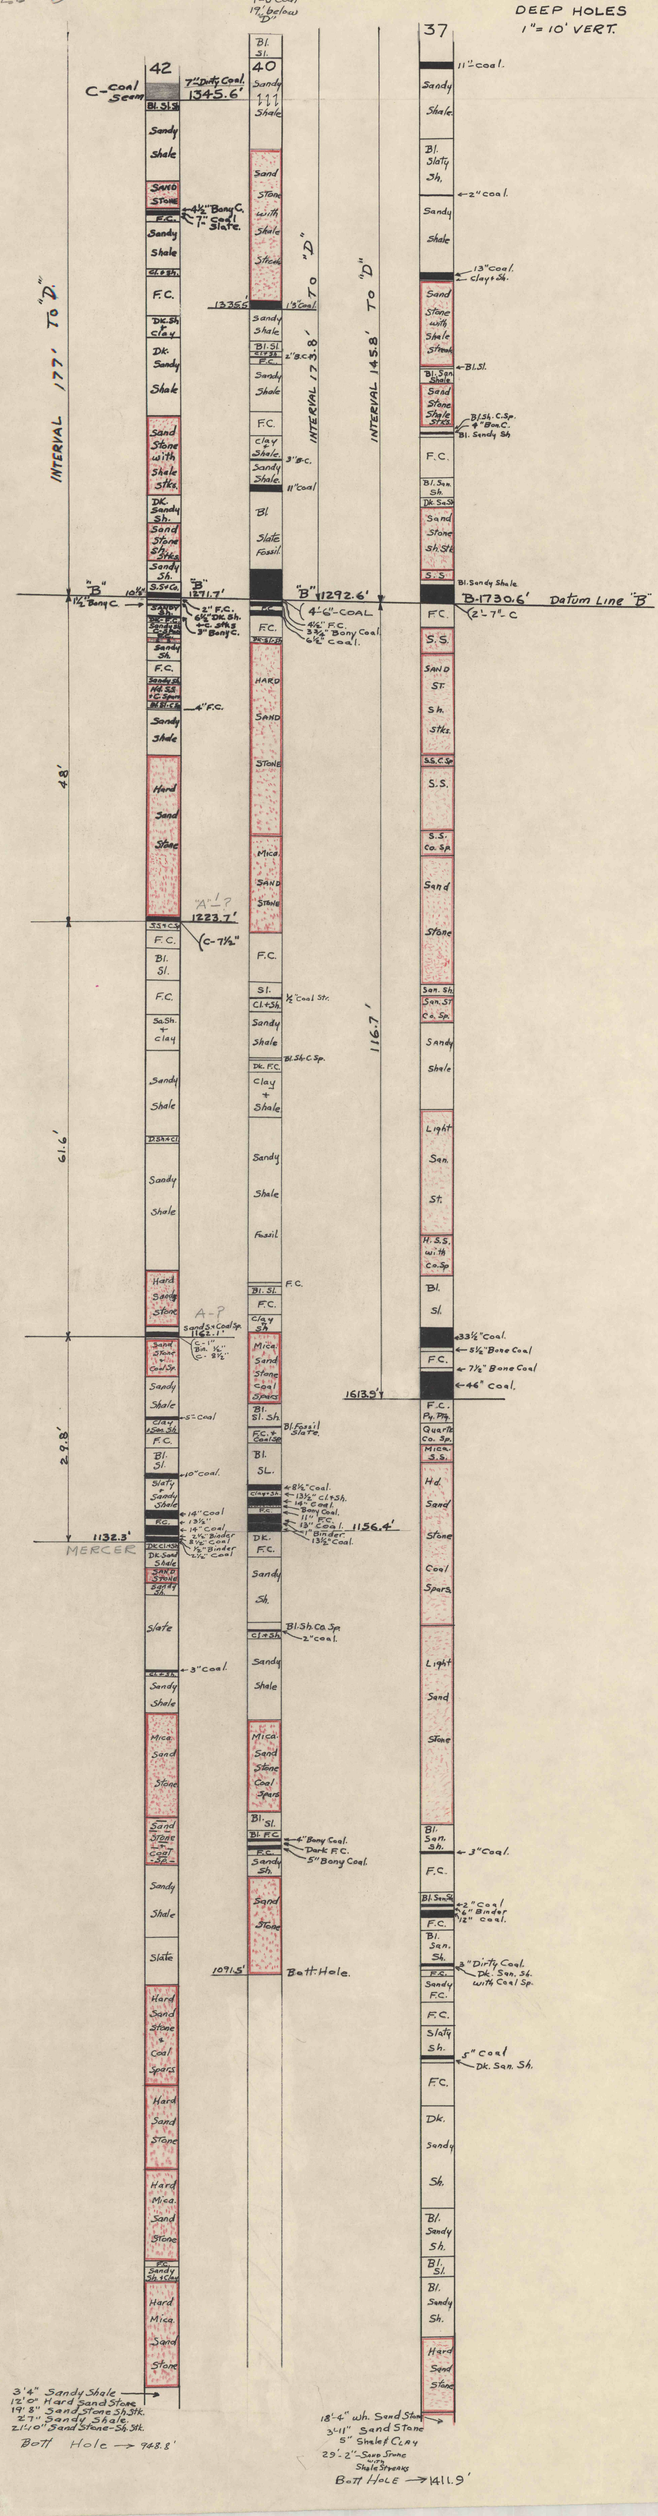
C-37a