





No-3 "HOFFMAN"
ON LAND OF
JOHNE WITHEROW

No-4-HOFFMAN
ON LAND OF
NEAR
OAK RIDGE SCHOOL

No-2-HOFFMAN
ON LAND OF
C. B. C. Co.

No-1-HOFFMAN
ON LAND OF
C. B. C. Co.

Vertical Scale 10 X 10 = 100 ft

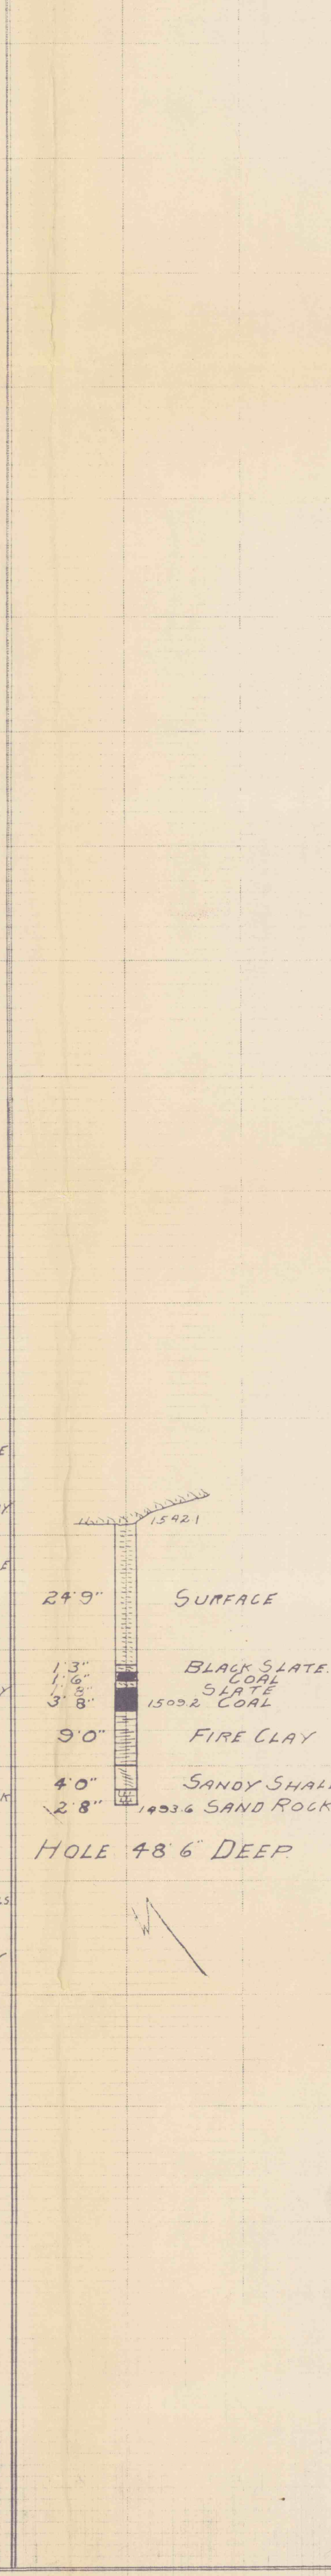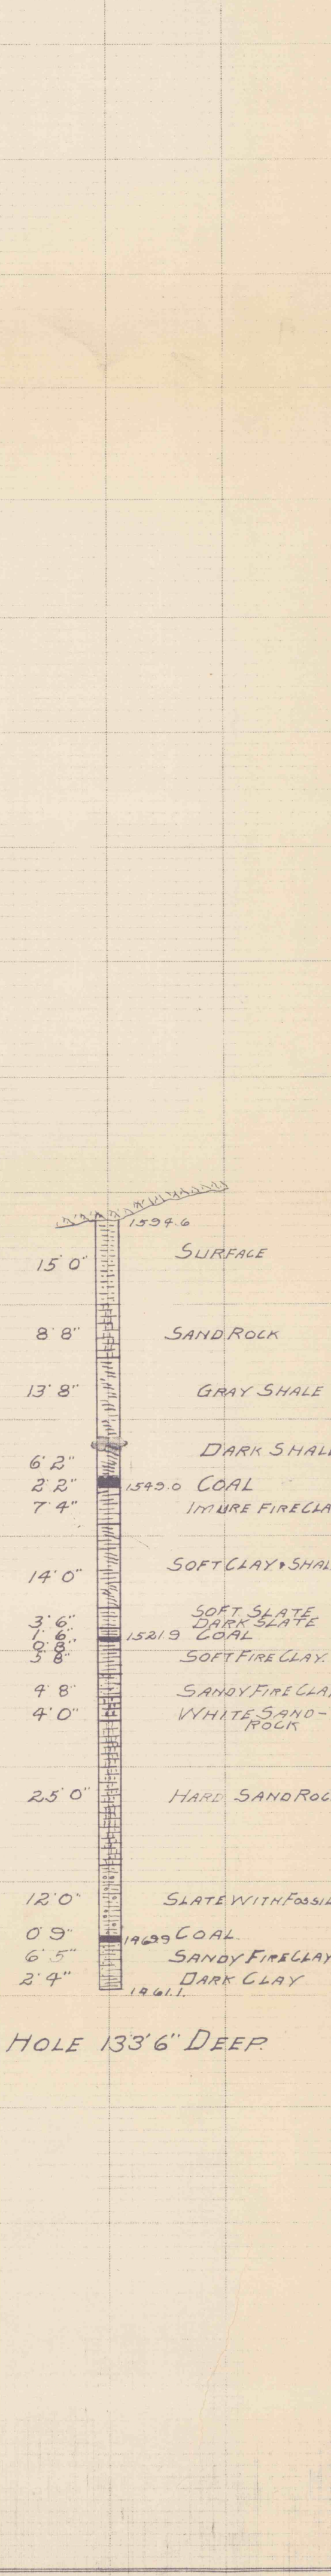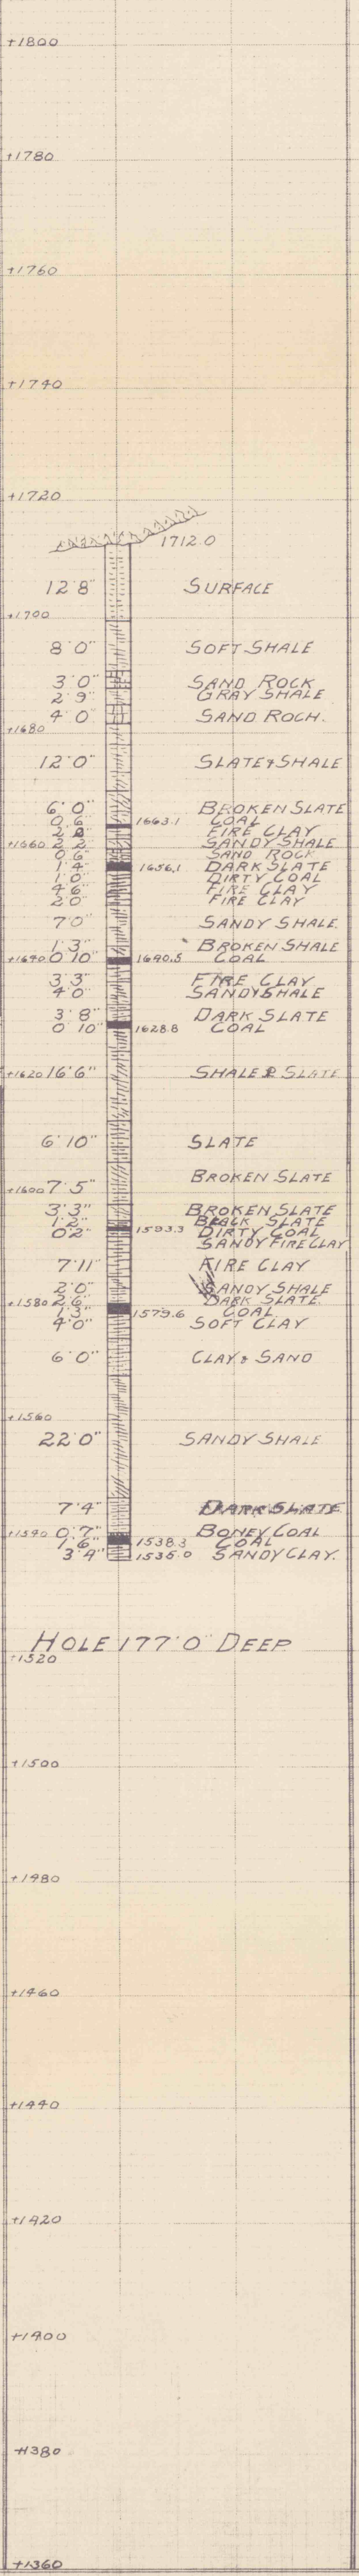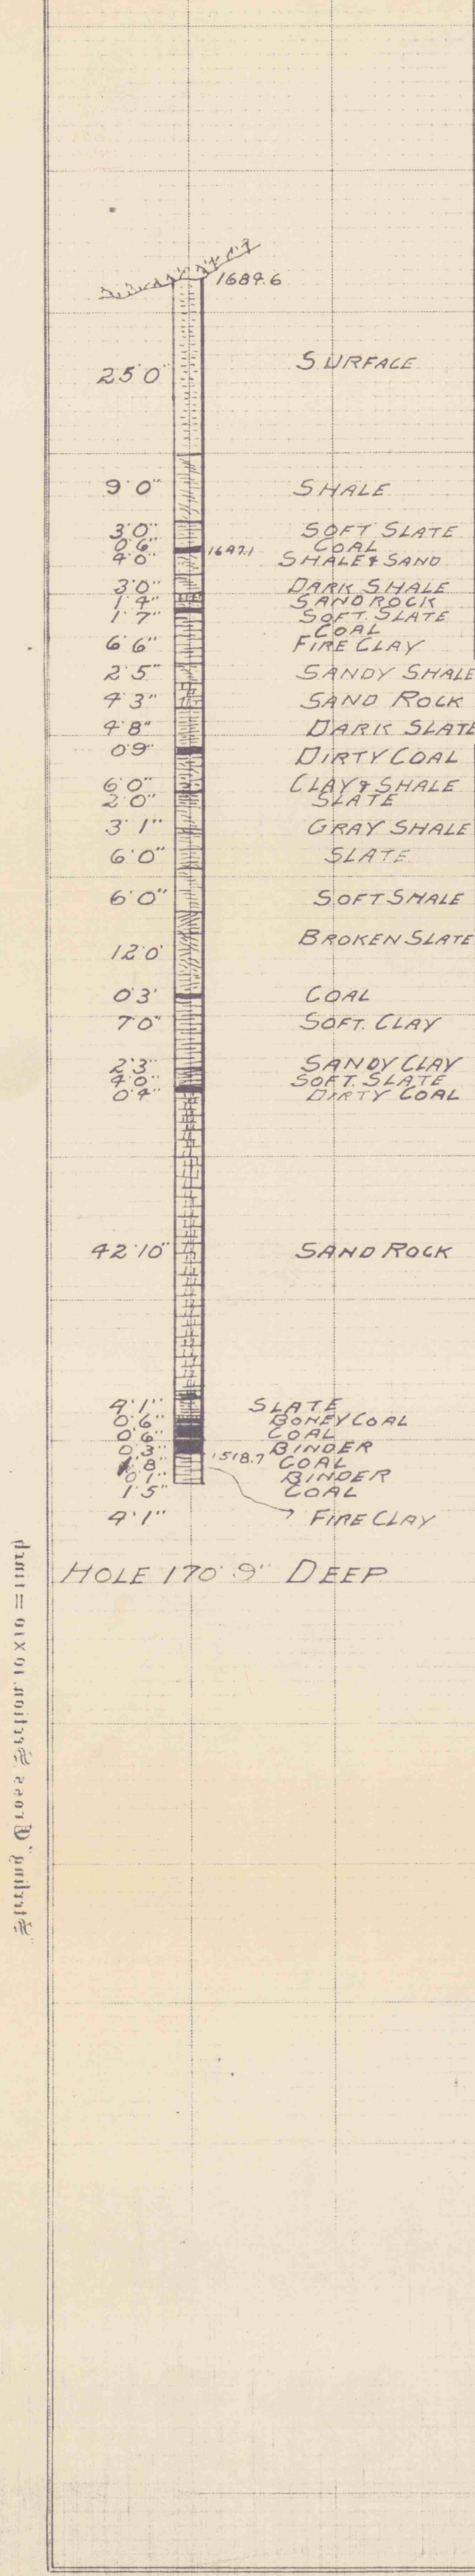

Vertical Scale 10 X 10 = 100 ft

#463
16-22-99
C.C.