

CARNWATH COAL COMPANY


RECORD OF DRILL-HOLES

ON "B" VEIN DEVELOPMENT

NEAR
CARNWATH PA.

CLEARFIELD PA.
JANUARY 25 1915

OFFICE OF E.W. HESS
ENGINEER.

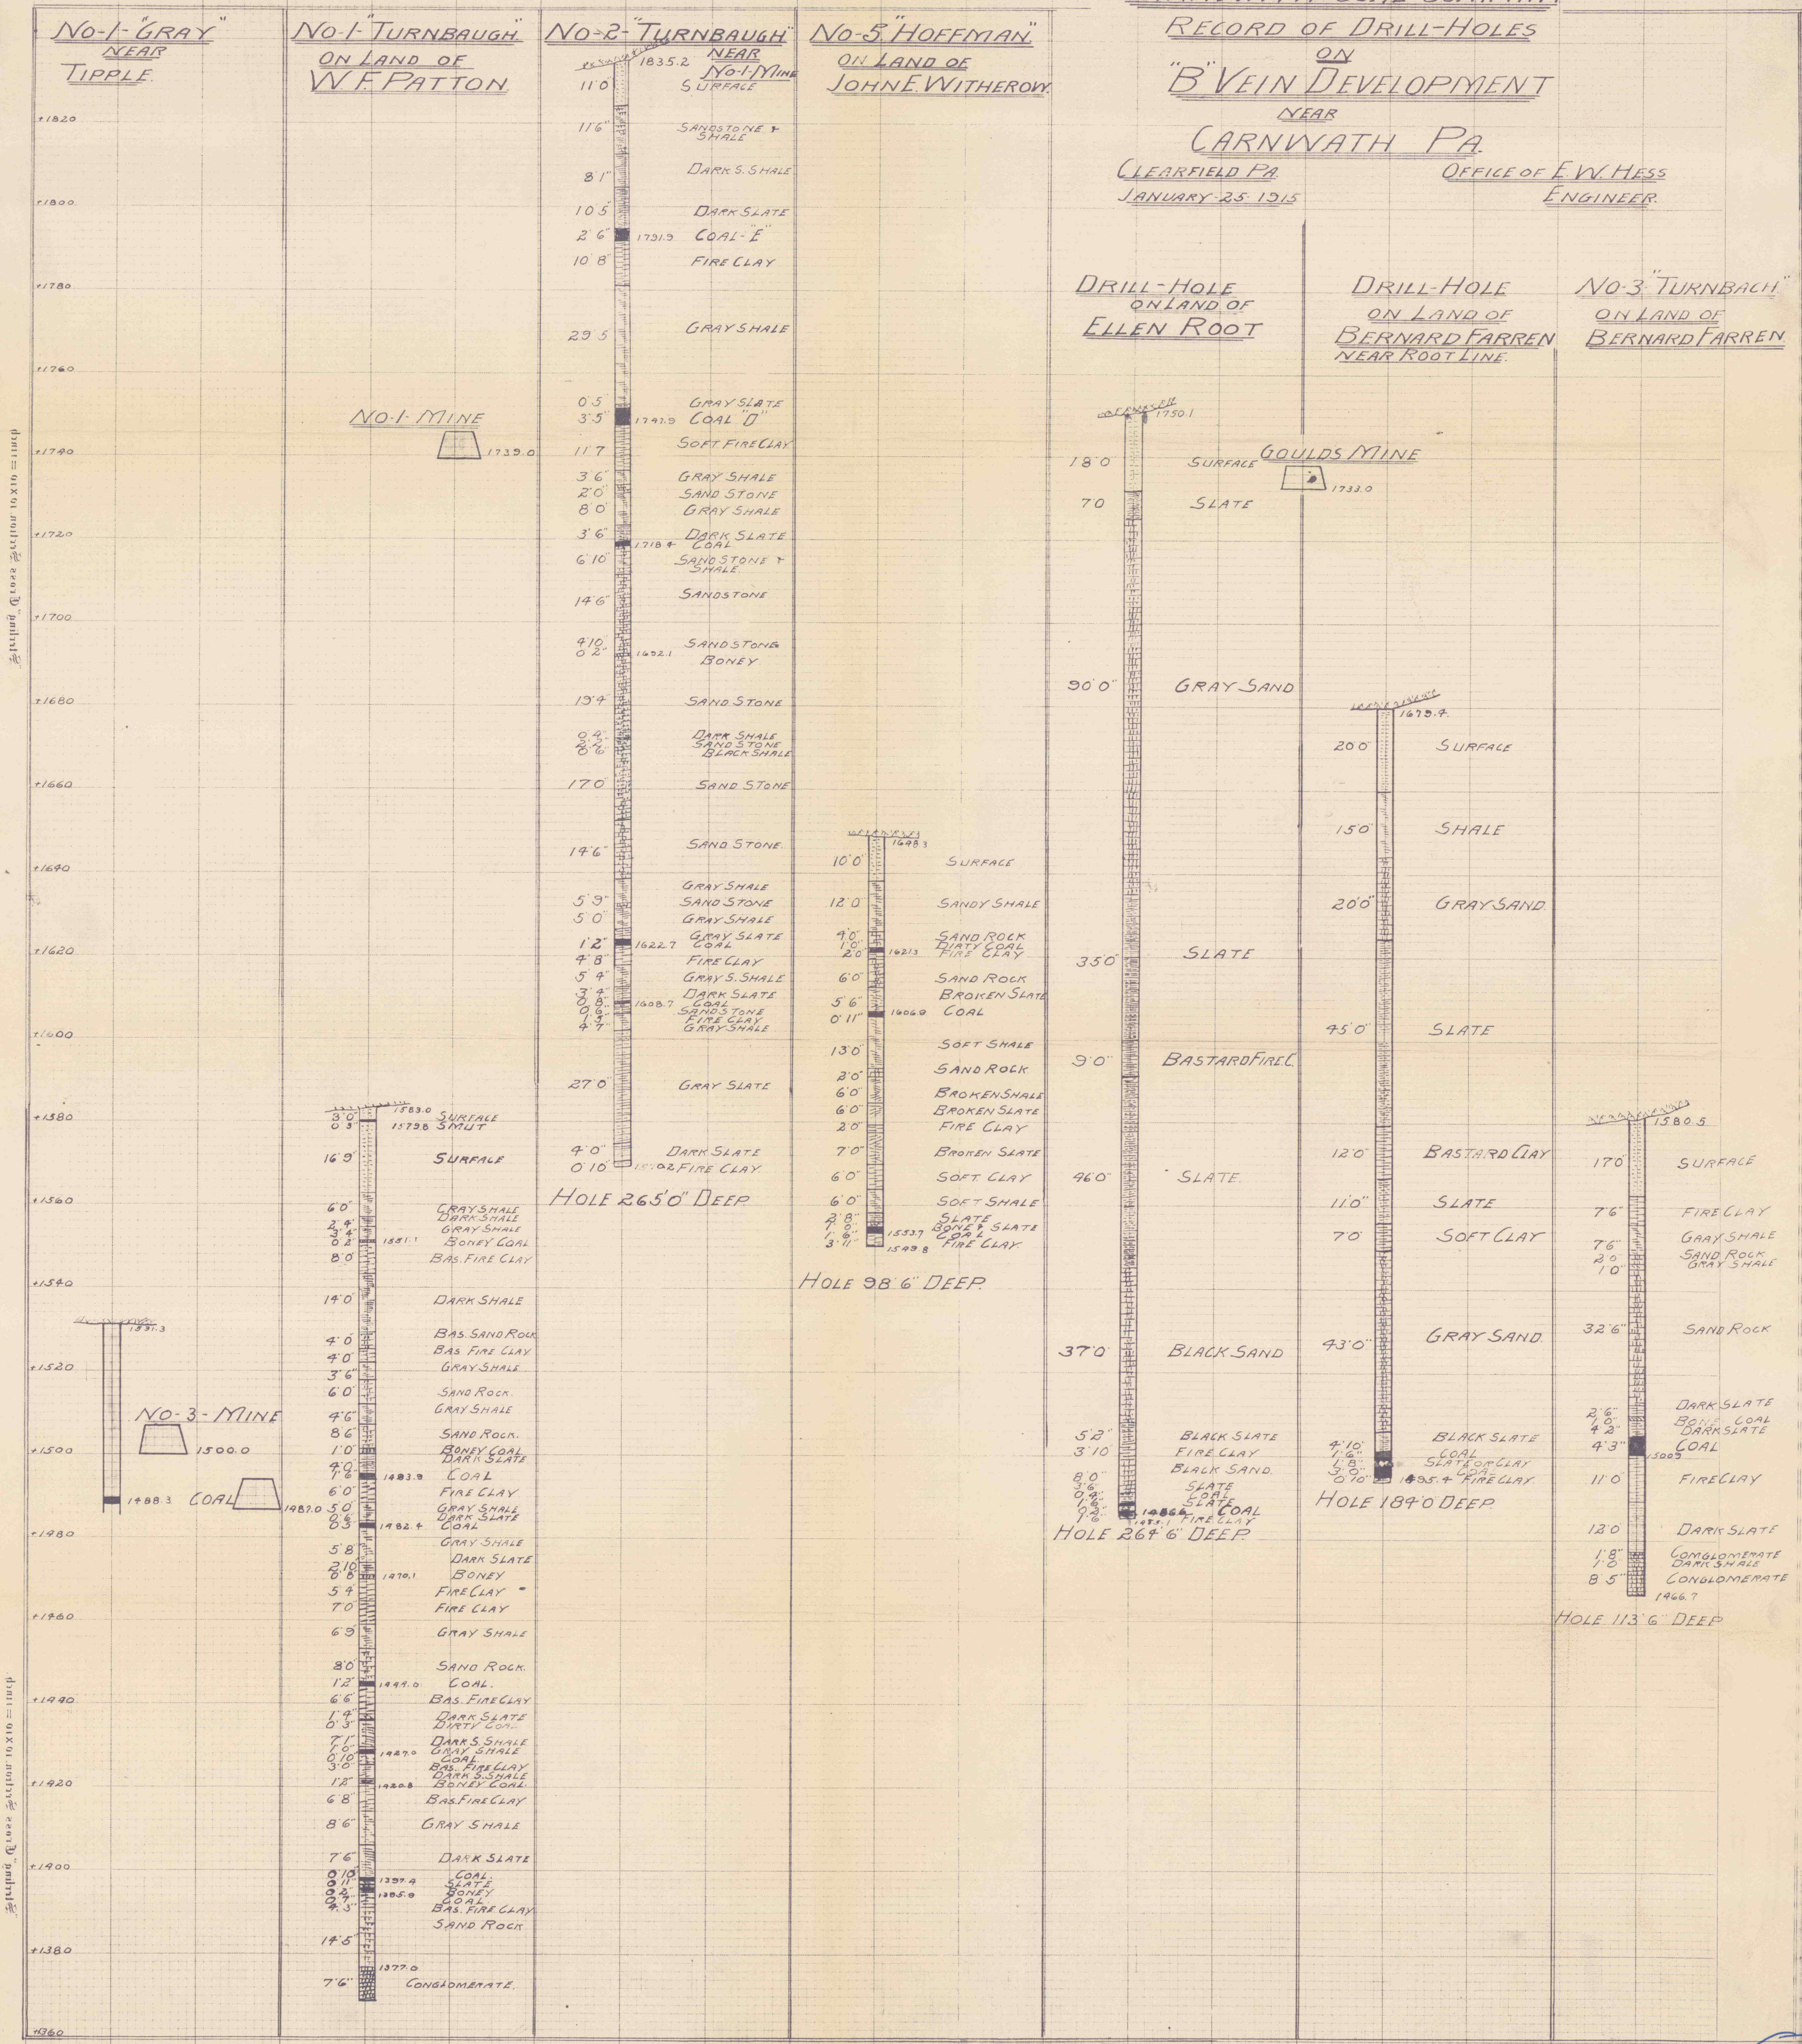

#463
6-22-99