



Jonathan Agey

NO. 4  
MARCH 21, 1910

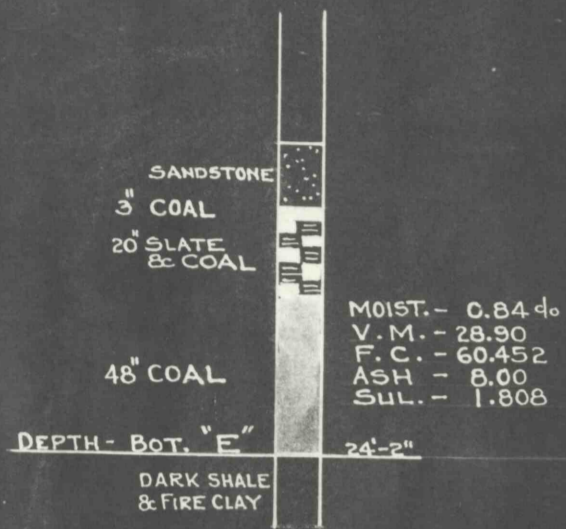


NO. 1  
MARCH 17, 1910

NO. 2  
MARCH 7, 1910

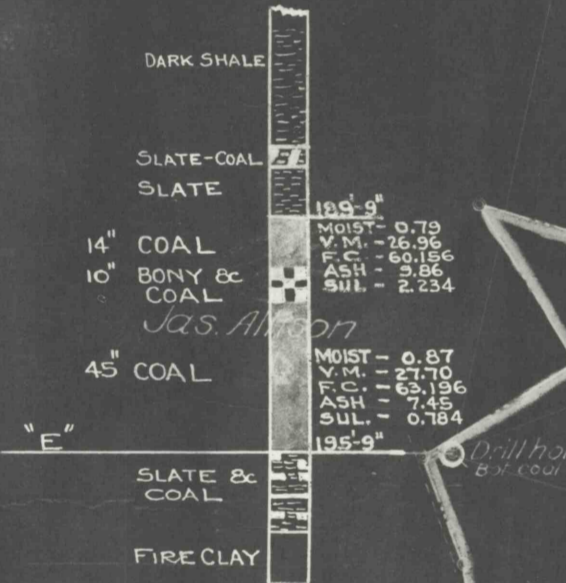

NO. 3  
MARCH 24, 1910

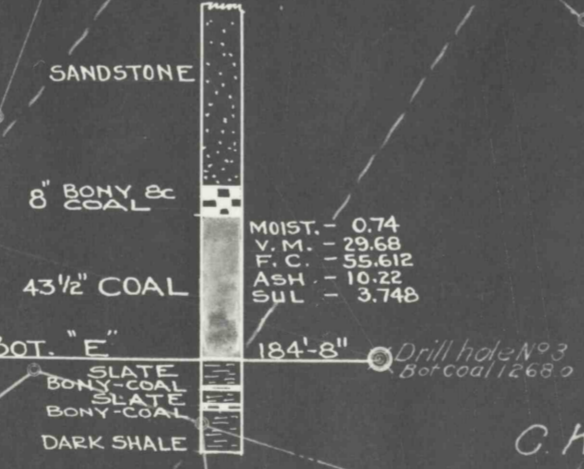

CLEARFIELD BITUMINOUS COAL CORPORATION  
SCHOONMAKER LANDS TOTAL ACREAGE = 960.6  
WHITE TOWNSHIP INDIANA COUNTY, PA.

DIAMOND DRILL HOLES BY J.R. RICHARDS. - COAL ANALYSES BY A.S. MCCREATH & SON.  
COAL SECTIONS AND ANALYSES - D.D. HOLES 1-25-52 P.G.



True Meridian