

COLONIAL NO. 1 MINE


H.C. FRICK COKE CO.

FAYETTE COUNTY, PA.

SCALE 1 INCH = 100 FT.

DATUM & LEVELS
U.S.G.S.

DATE OF LAST SURVEY

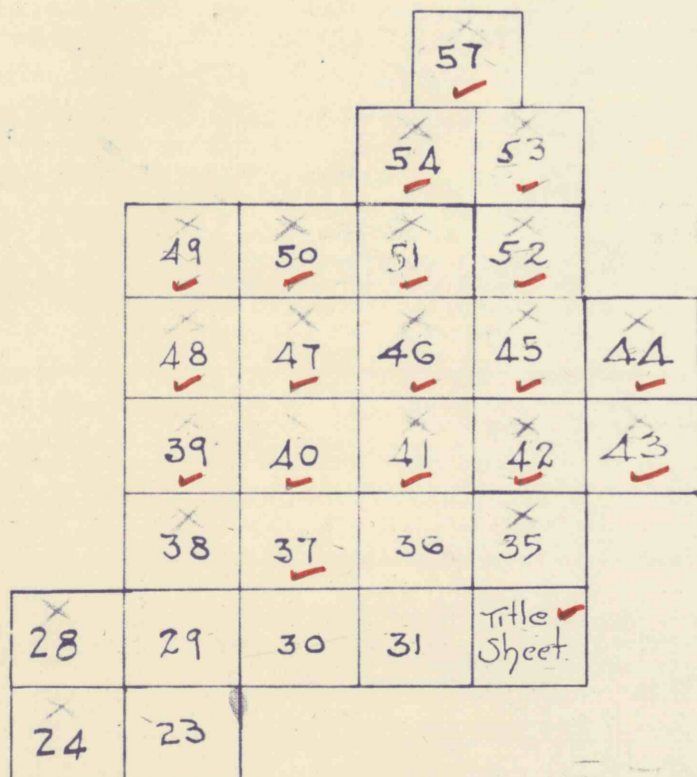

DATE	SURVEY LETTER	PLOTTED BY	TRACED BY	DATE	SURVEY LETTER	PLOTTED BY	TRACED BY	DATE	SURVEY LETTER	PLOTTED BY	TRACED BY
9-30-11	A	HCE	HCE	6-30-25	I-1	WER	WER	6-30-42	Q-2	LRE	LRE
1-3-12	B	HCE	HCE	1-8-26	J-1	WER	WER	2-17-42	R-2	WRD	WRD
3-30-12	C	HCE	HCE	6-30-26	K-1	RGB	RGB	6-30-43	S-2	LRE	LRE
6-30-12	D	HCE	HCE	12-11-26	L-1	WER	WER	12-15-43	T-2	LRE	LRE
10-18-12	E	CEZ	CEZ	6-30-27	M-1	RGB	RGB	6-30-44	U-2	LRE	LRE
12-26-12	F	HCE	HCE	12-14-27	N-1	RGB	AMS				
4-4-13	G	HCE	HCE	6-30-28	O-1	RGB	AMS				
6-30-13	H	HCE	HCE	12-12-28	P-1	RGB	AMS				
10-3-13	I	HCE	HCE	6-29-28	Q-1	EGS	EGS				
12-27-13	J	HCE	HCE	12-16-29	R-1	EGS	EGS				
3-31-14	K	HCE	HCE	6-30-30	S-1	AMS	AMS				
6-30-14	L	HCE	HCE	12-15-30	T-1	E.S.	E.S.				
10-9-14	M	HCE	HCE	6-30-31	U-1	A.S.	A.S.				
12-23-14	N	HCE	HCE	12-12-31	V-1	AMS	AMS				
6-29-15	O	HCE	HCE	6-30-32	W-1	AMS	AMS				
12-11-15	P	HCE	HCE	12-12-32	X-1	AMS	AMS				
7-7-16	Q	T.S.	T.S.	6-30-33	Y-1	AMS	AMS				
1-8-17	R	T.S.	WLO	12-15-33	Z-1	AMS	AMS				
6-26-17	S	WLO	WLO	6-30-34	A-2	AMS	AMS				
12-26-17	T	WLO	WLO	12-24-34	B-2	AMS	AMS				
6-28-18	U	JES	JES	6-29-35	C-2	AMS	AMS				
1-7-19	V	RGB	RGB	12-14-35	D-2	AMS	AMS				
5-24-19	W	RGB	RGB	6-30-36	E-2	AMS	AMS				
1-7-20	X	RGB	R.R.	12-15-36	F-2	LRE	LRE				
6-30-20	Y	WH	WH	6-30-37	G-2	LRE	LRE				
12-22-20	Z	WH	WH	12-15-37	H-2	AMS	AMS				
3-24-21	A-1	WH	WH	6-30-38	I-2	LRE	LRE				
12-30-21	B-1	WER	WER	12-15-38	J-2	LRE	LRE				
6-30-22	C-1	WH	WH	6-30-39	K-2	LRE	LRE				
1-5-23	D-1	RGB	RGB	12-15-39	L-2	LRE	LRE				
6-30-23	E-1	WH	WH	6-29-40	M-2	LRE	LRE				
1-4-24	F-1	WER	WER	12-14-40	N-2	LRE	LRE				
6-30-24	G-1	RGB	RGB	6-30-41	O-2	LRE	LRE				
1-2-25	H-1	WER	WER	12-15-41	P-2	LRE	DRS.				

Note:-
See Colonial # 3
Title Sheet

#601
6-29-99
C.C.