


INDEX FOR 100' MAPS

INDEX FOR 400' MAPS

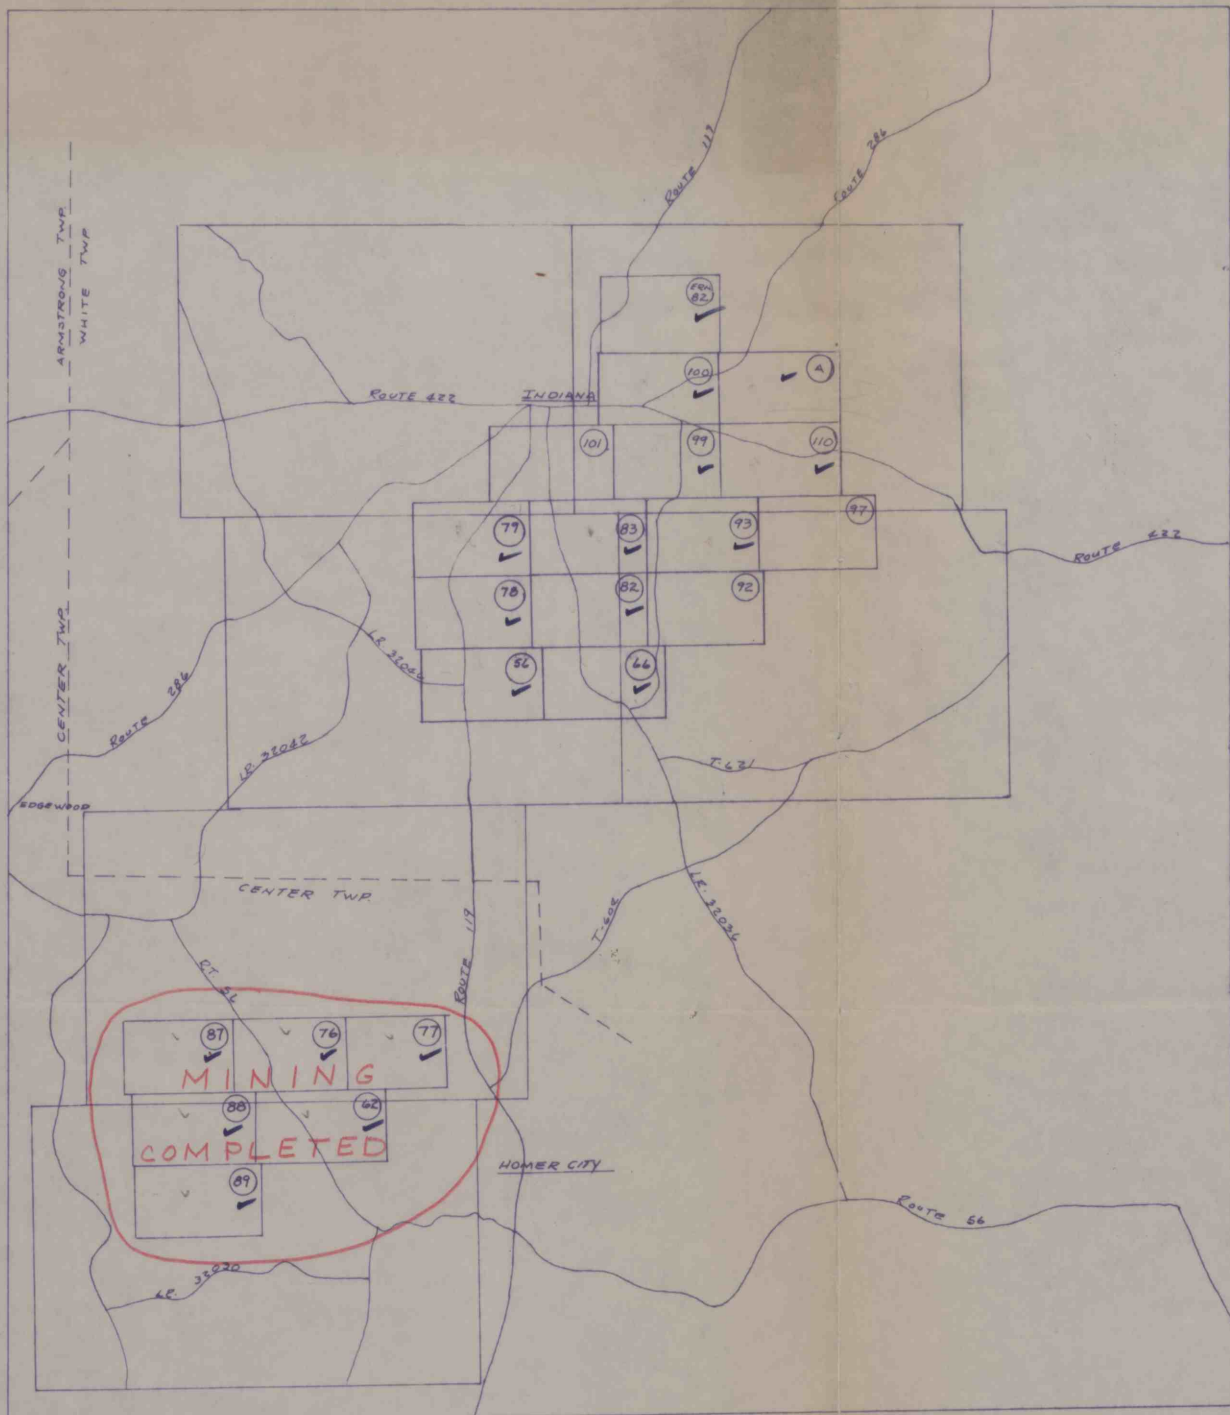

SCALE 1" = 4000'

SCALE 1" = 5208'

LUCERNE MINE
100' MAPS


ROCHESTER & PITTSBURGH COAL COMPANY
INDIANA U.S.G.S. QUADRANGLE

LUCERNEMINES, PA.
PROPERTY MAP


SCALE 1" = 5208'

SCALE 1" = 400'

DOTTED LINE SHOWS
OUTLINE OF PROTECTED AREA.

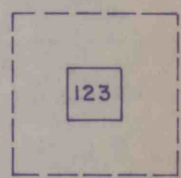


PROPOSED MINING PROJECTIONS.

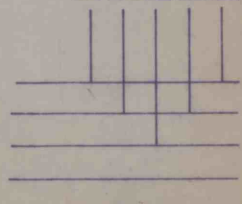

DURING THE SIX MONTH PERIOD
MINING WILL BE PERFORMED
IN AREA OUTLINED IN RED.





GREEN LINE SHOWS
AREA TO BE MINED.

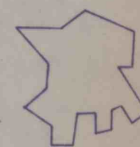

SHEET NUMBER.



SOLID BLACK LINES SHOW
OUTLINE OF EACH SHEET.

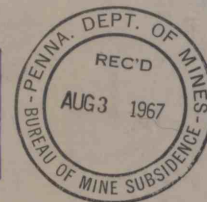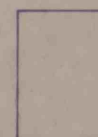

GREEN LINES SHOW
AREA TO BE MINED.



SHEET NUMBER.



STRUCTURE AND NUMBER.

