


COLVER MINE
B SEAM

EASTERN ASSOCIATED COAL CORP.
CAMBRIA COUNTY, COLVER, PA.

SCALE: 1"=100'

MAY 2, 1978
FINAL POSTING

Michael D. Eddy, Jr.
REGISTRATION NO. 15275-E

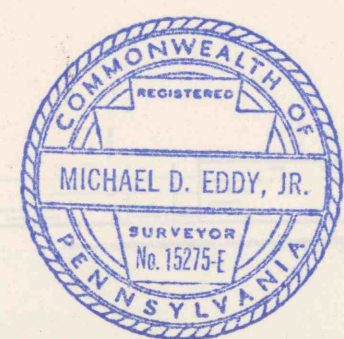

COLVER 100' MAPS