

SUBSIDENCE PERMIT
BOUNDARY
INDEX FOR 100' MAPS



WHITESBURG 7-1/2' U.S.G.S. QUADRANGLE
SCALE 1"=2000


= MAPS SUBMITTED

KEYSTONE COAL MINING CORPORATION
MARGARET NO. 11-NO. 3 PORTAL
PERMIT NO. 03851304
UPPER FREEPORT (E SEAM)
KITTANNING TWP.
ARMSTRONG COUNTY, PENNSYLVANIA.

RECEIVED
MAY - 2 2005
BUREAU OF DEEP MINE SAFETY

FINAL
POSTING DATE NOV. 18 1994

SEAL —

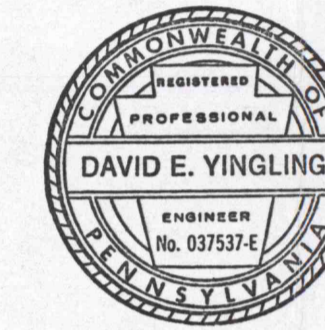

SIGNATURE *David E. Yingling*

PREPARED BY R. HITCHINGS

MAPS DEPICT CONTEMPLATED MINING (NO FURTHER MINING CONTEMPLATED)
FROM N/A, 19
TO N/A, 19

RECEIVED
FEB 22 1995
Dept. of Environmental Resources
McMurry District Office

LEGEND FOR MAP SYMBOLS

ACTIVE GAS WELL	T494 TOWNSHIP ROAD	MINING COMPLETED
INACTIVE GAS WELL	BRIDGE	CONSTRUCTED DIKE OR EMBANKMENT
WATER WELL	CULVERT	TOE OF EXISTING SPOIL, MINE ROCK OR COAL REFUSE PILE
SPRING	ELEVATIONS-ROAD	(NAME) ORIGINAL COAL OWNER, SHOWN FOR REFERENCE ONLY
POND	ELEVATIONS-STREAM	ALL ENTRIES TO BE MINED 20' NOMINAL WIDTH WITH THE EXCEPTION OF BELT/TRACK ENTRIES WHICH WILL BE MINED 22' NOMINAL WIDTH.
FLOW MEASUREMENT POINT	RAILROAD TRACKS	ALL COAL IS OWNED OR LEASED BY ROCHESTER & PITTSBURGH COAL COMPANY UNLESS OTHERWISE DESIGNATED ON THE MAPS.
STREAM-PERENNIAL	HORIZONTAL OR VERTICAL CONTROL, SURVEY STATIONS	PILLARS TO BE LEFT FOR SUPPORT IN PROTECTED ZONES ARE SHADED.
STREAM-INTERMITTENT	DIAMOND (DDH) OR AIR DRILL (ADH) HOLE AS LABELED	FIRST MINING INDICATES NO PILLAR REMOVAL
PIPELINE OR UNDERGROUND CABLE (SIZE, OIL, OR GAS AS LABELED)	SWAMP OR MARSH	
PROPERTY LINE	DITCH	
POWER LINE	STRUCTURE	
COAL CONTOUR LINE	DWELLING-BUILT AFTER APRIL 1966	
NO COAL ZONE	CHURCH	
CROPLINE	CEMETERY	
100' COVER LINE	AIR SHAFT (DOUBLE COMPARTMENT)	
9 MONTH SUBSIDENCE LINE (CONTEMPLATED MINING & DATE)	PILLARED	
SUBSIDENCE CONTROL PLAN BOUNDARY	OUTLINE OF PILLARED AREA UPPER OR LOWER SEAM	
PERMIT BOUNDARY		
STATE ROAD		
UNIMPROVED ROAD		

NOTE: FIRST MINING INDICATES NO PILLAR REMOVAL
MARG-11-NO.3-1AD