






Map compiled, edited, and published by the Geological Survey
Control by USGS, USCGS, and USCE
Topography by photogrammetric methods from aerial
photographs taken 1958. Field checked 1961
Polyconic projection. 1927 North American datum
10,000-foot grid based on Pennsylvania coordinate system,
south zone
1000 meter Universal Transverse Mercator grid ticks,
zone 17, shown in blue
Line of dashed lines indicate selected fence and field lines where
energy visible on aerial photographs. This information is uncheck
Revisions shown in purple compiled in cooperation with State of
Pennsylvania agencies from aerial photographs taken 1977 and other
source data. This information not field checked. Map edited 1979
Boundary lines shown in purple compiled from latest
information available from the controlling authority

Map compiled, edited, and published by the Geological Survey
Control by USGS, USCGS, and USCE
Topography by photogrammetric methods from aerial photographs
taken 1962 and 1963. Field checked 1964
Polyconic projection. 1927 North American datum
10,000-foot grid based on Pennsylvania coordinate system, south zone
1000 meter Universal Transverse Mercator grid ticks,
zone 17, shown in blue
Line of dashed lines indicate selected fence and field lines where
generally visible on aerial photographs. This information is uncheck
There may be private inholdings within the boundaries of
the National or State reservations shown on this map
To place on the predicted North American Datum 1983
move the projection lines 5 meters south and
18 meters west as shown by dashed corner ticks

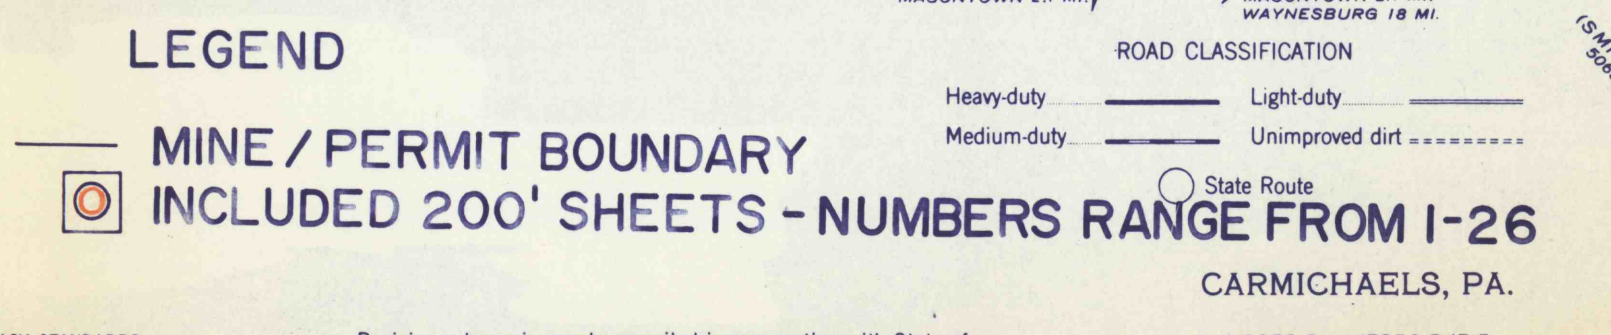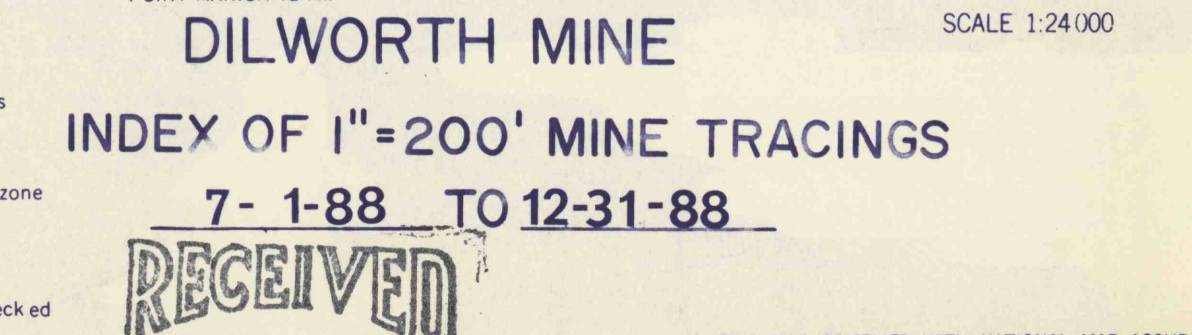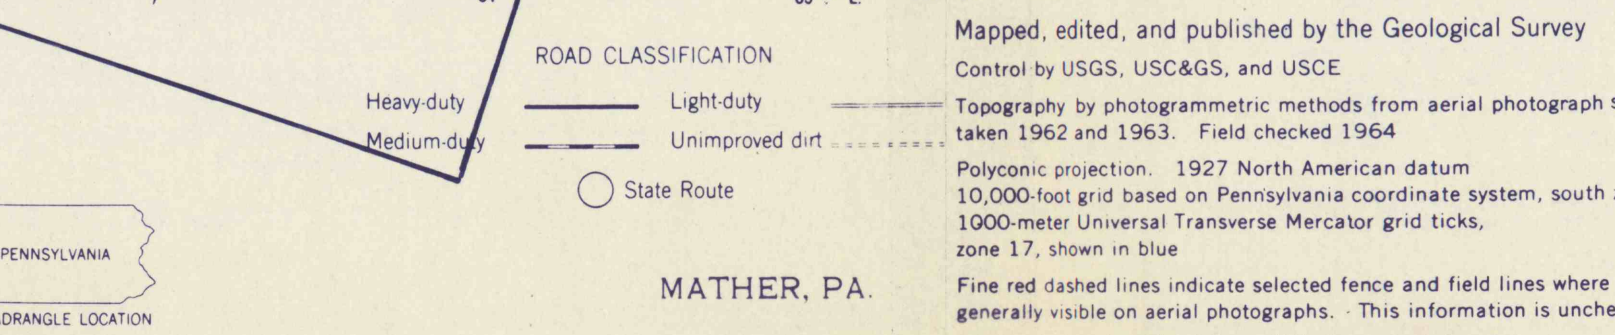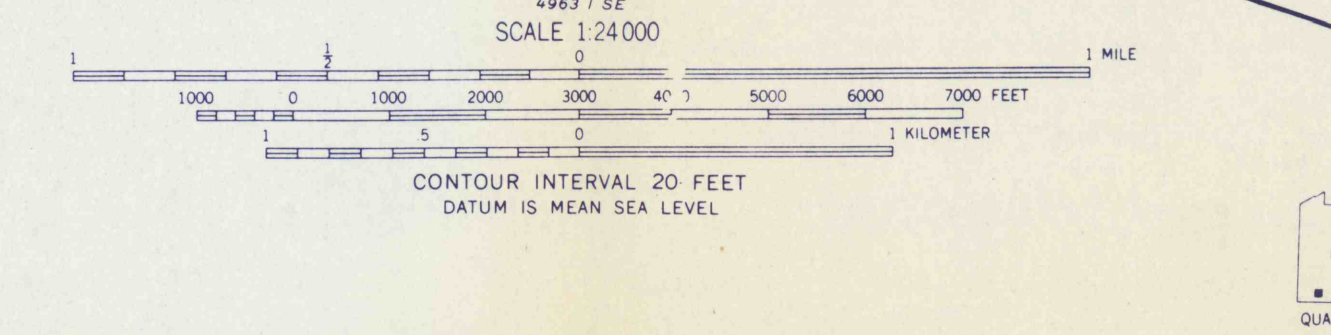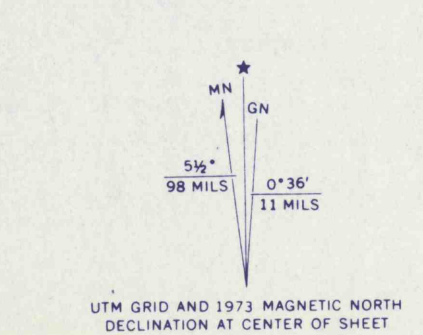

DILWORTH MINE
INDEX OF 1"=200' MINE TRACINGS
7-1-88 TO 12-31-88
RECEIVED
JUL 9 1988
Dept. of Environmental Resources
Waynesburg District Office

LEGEND
MINE / PERMIT BOUNDARY
INCLUDED 200' SHEETS - NUMBERS RANGE FROM 1-26
ROAD CLASSIFICATION
Heavy-duty
Medium-duty
Light-duty
Unimproved dirt
State Route
CARMICHAELS, PA.
N 3952.5 - W 7952.5 / 7.5
1964
PHOTOREVISED 1979
AMS 5083 IV NW - SERIES Y831