

CONSOLIDATION COAL COMPANY

# DILWORTH MINE

36-04281

RICES LANDING BORO.  
GREENE COUNTY PA.

SCALE 1" = 200'


MAP PREPARED AS OF DECEMBER 31, 2002  
PROJECTED TO FINAL MAP  
CLOSE LOOP SURVEY ACCURACY 1:15,000  
INDIVIDUAL RESPONSIBLE FOR INFORMATION ON MAP:

THESE MAPS SATISFY THE REQUIREMENTS OF BOTH 75.372 & 75.1200 AS OF THE DATE PREPARED.

7


THERE ARE NO KNOWN WORKINGS ABOVE OR BELOW THIS MINE.

OXYGEN CONTENT AT BLEEDER EVALUATION POINTS IS GREATER THAN 19.5 %

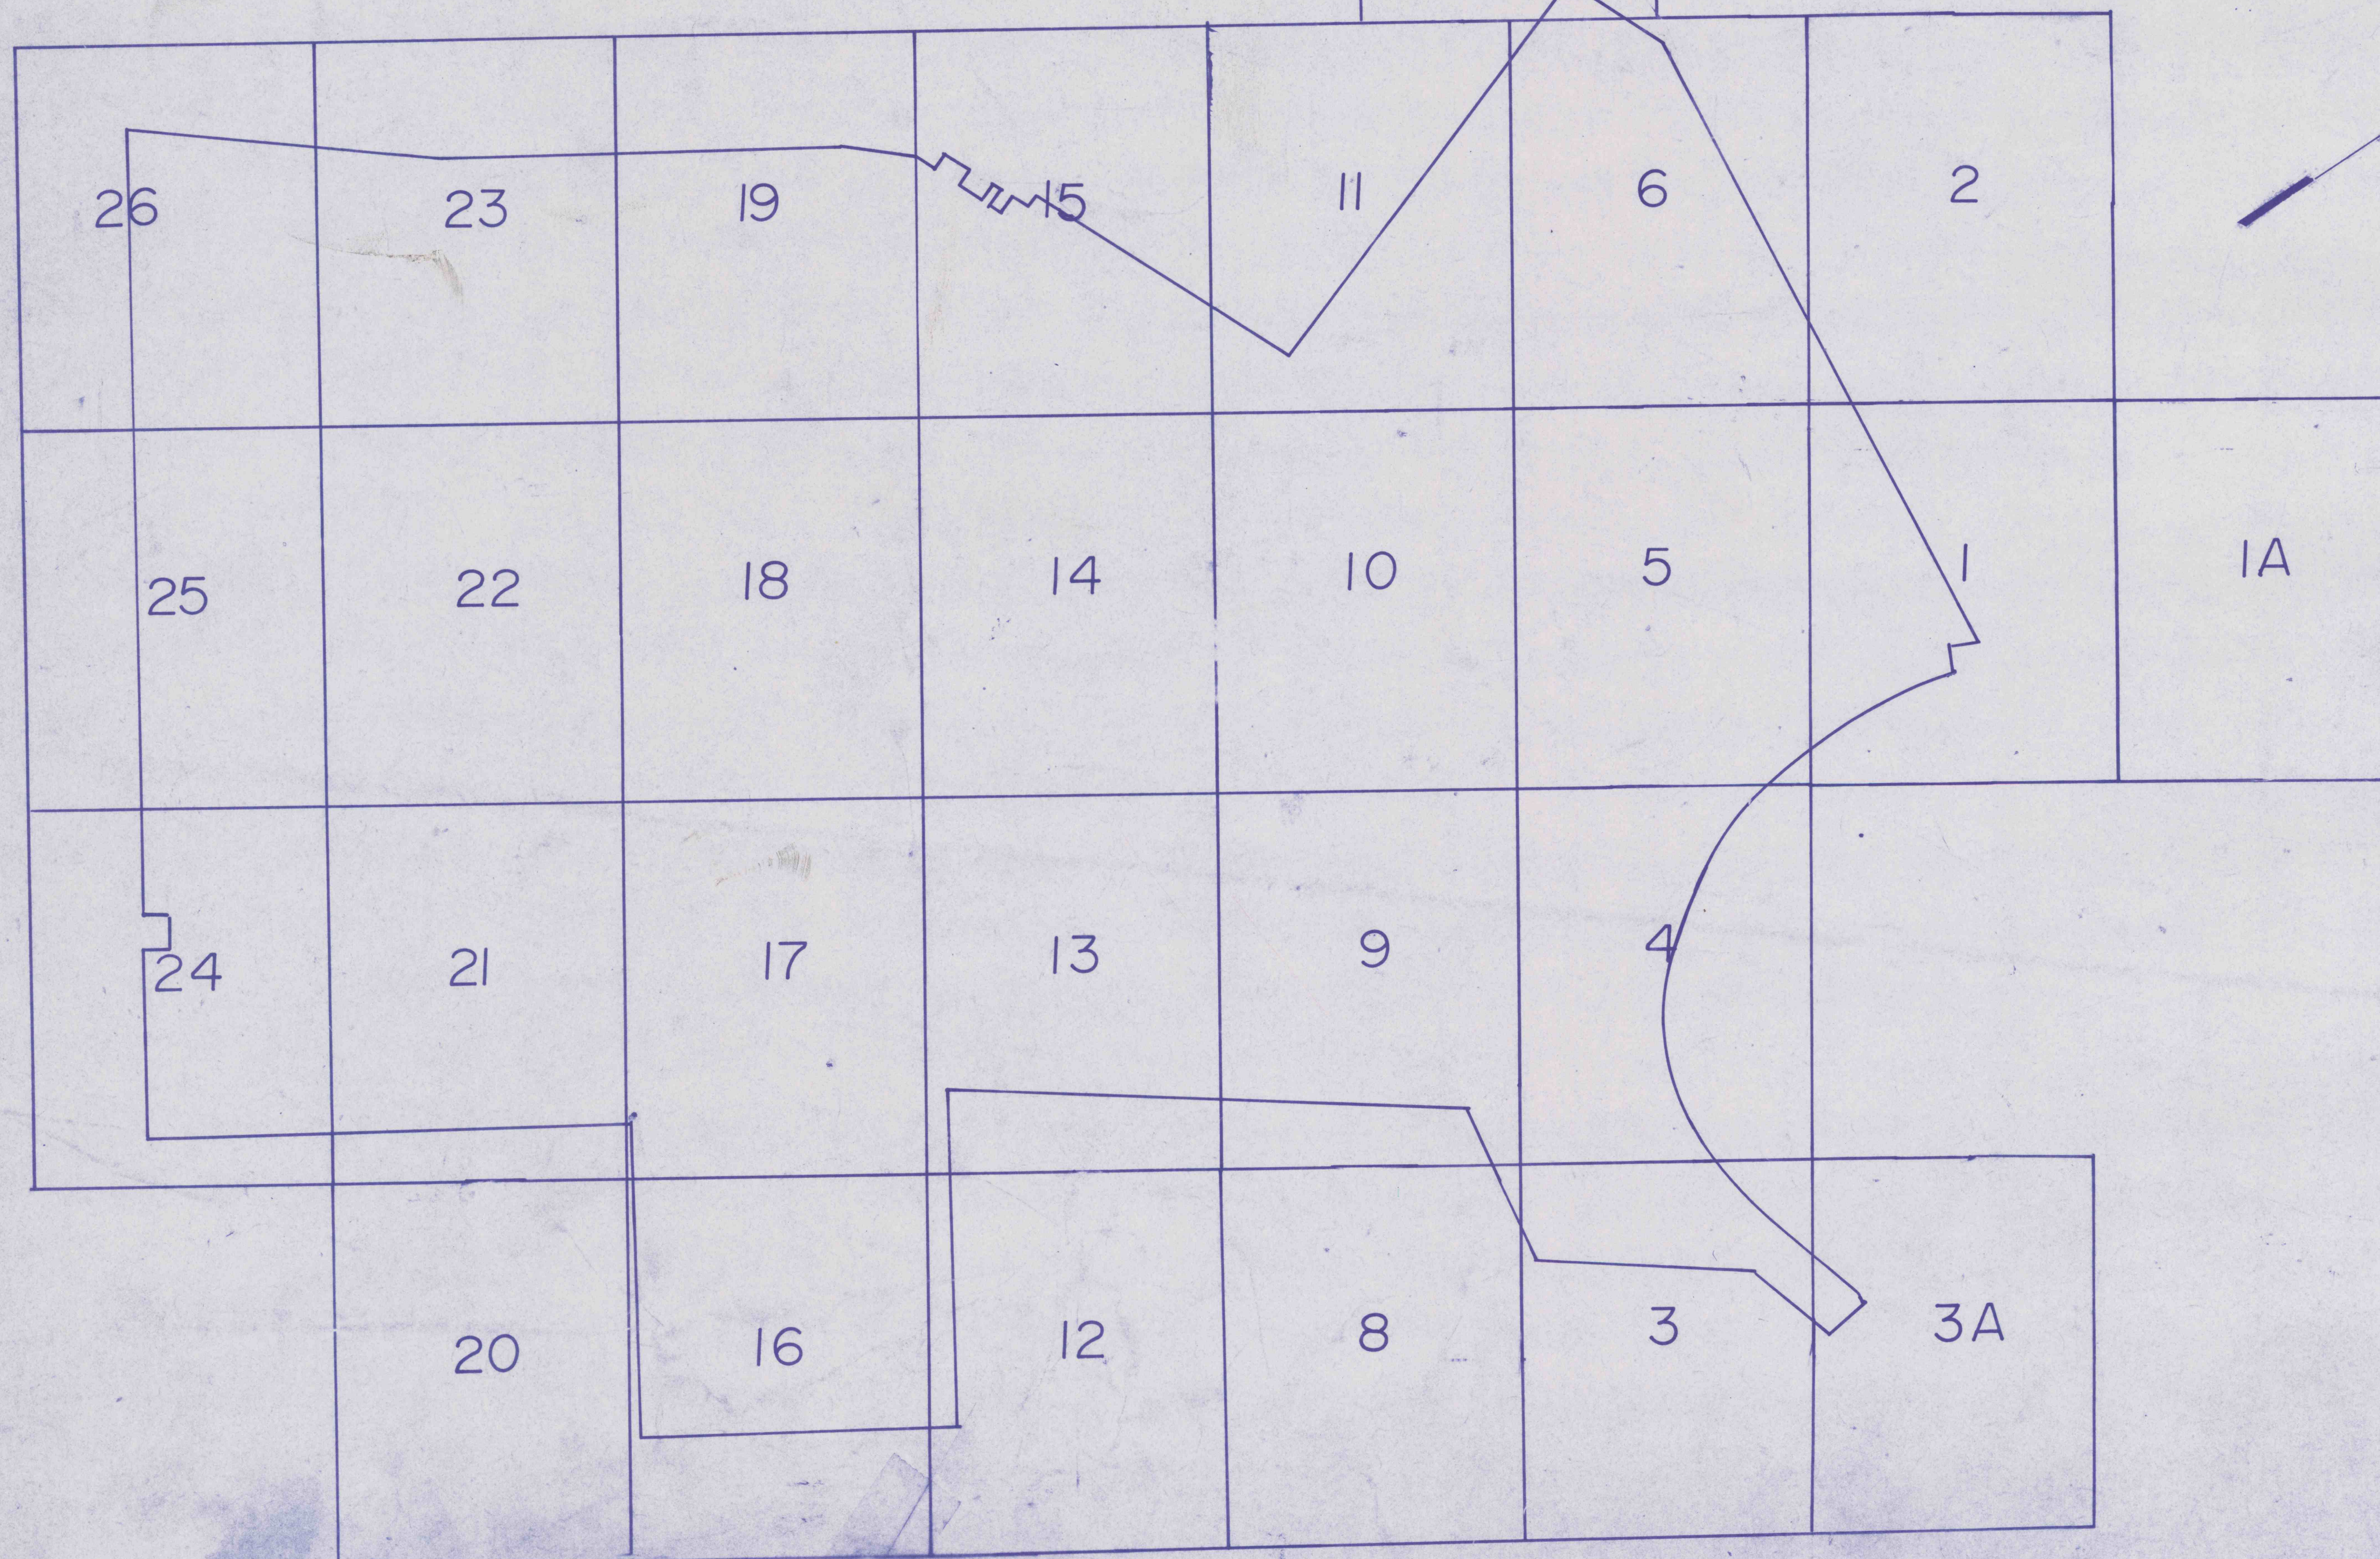

## LEGEND

- 530-- BOTTOM OF COAL ELEVATION
- TRACK DOOR    K KENNEDY STOPPING
- I, II STOPPING    \$ SEAL
- REGULATOR
- X OVERCAST    X OVERCAST WITH MANDOOR
- INTAKE AIR DIRECTION    AIR LEAKAGE
- PRIMARY ESCAPEWAY    ALTERNATE ESCAPEWAY
- AIR LOCK SYSTEM
- OIL OR GAS WELL
- OVERPASS    X OVERCAST WITH BLOCK OUT
- TRACK    PRIMARY ESCAPEWAY & TRACK ENTRY DURING DEVELOPMENT
- BELT
- VENTILATION BOREHOLE (GOB DE-GAS HOLE)
- CLOSED REGULATOR
- WATER AREA
- STOPPING WITH BLOCK(S) OUT
- STOPPING WITH MAN DOOR & BLOCK(S) OUT
- BOX CHECK    CO MONITOR
- STREAM
- POND
- GOB    GOB    GOB

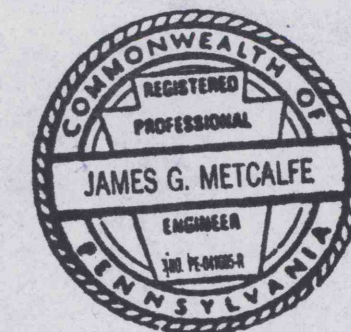

*James G. Metcalfe*