


FILE NEXT TO 300 1967

100' SHEET INDEX ROBENA MINE

See Sheet No 381 for mining dates

FEB 2 - Reord 1967

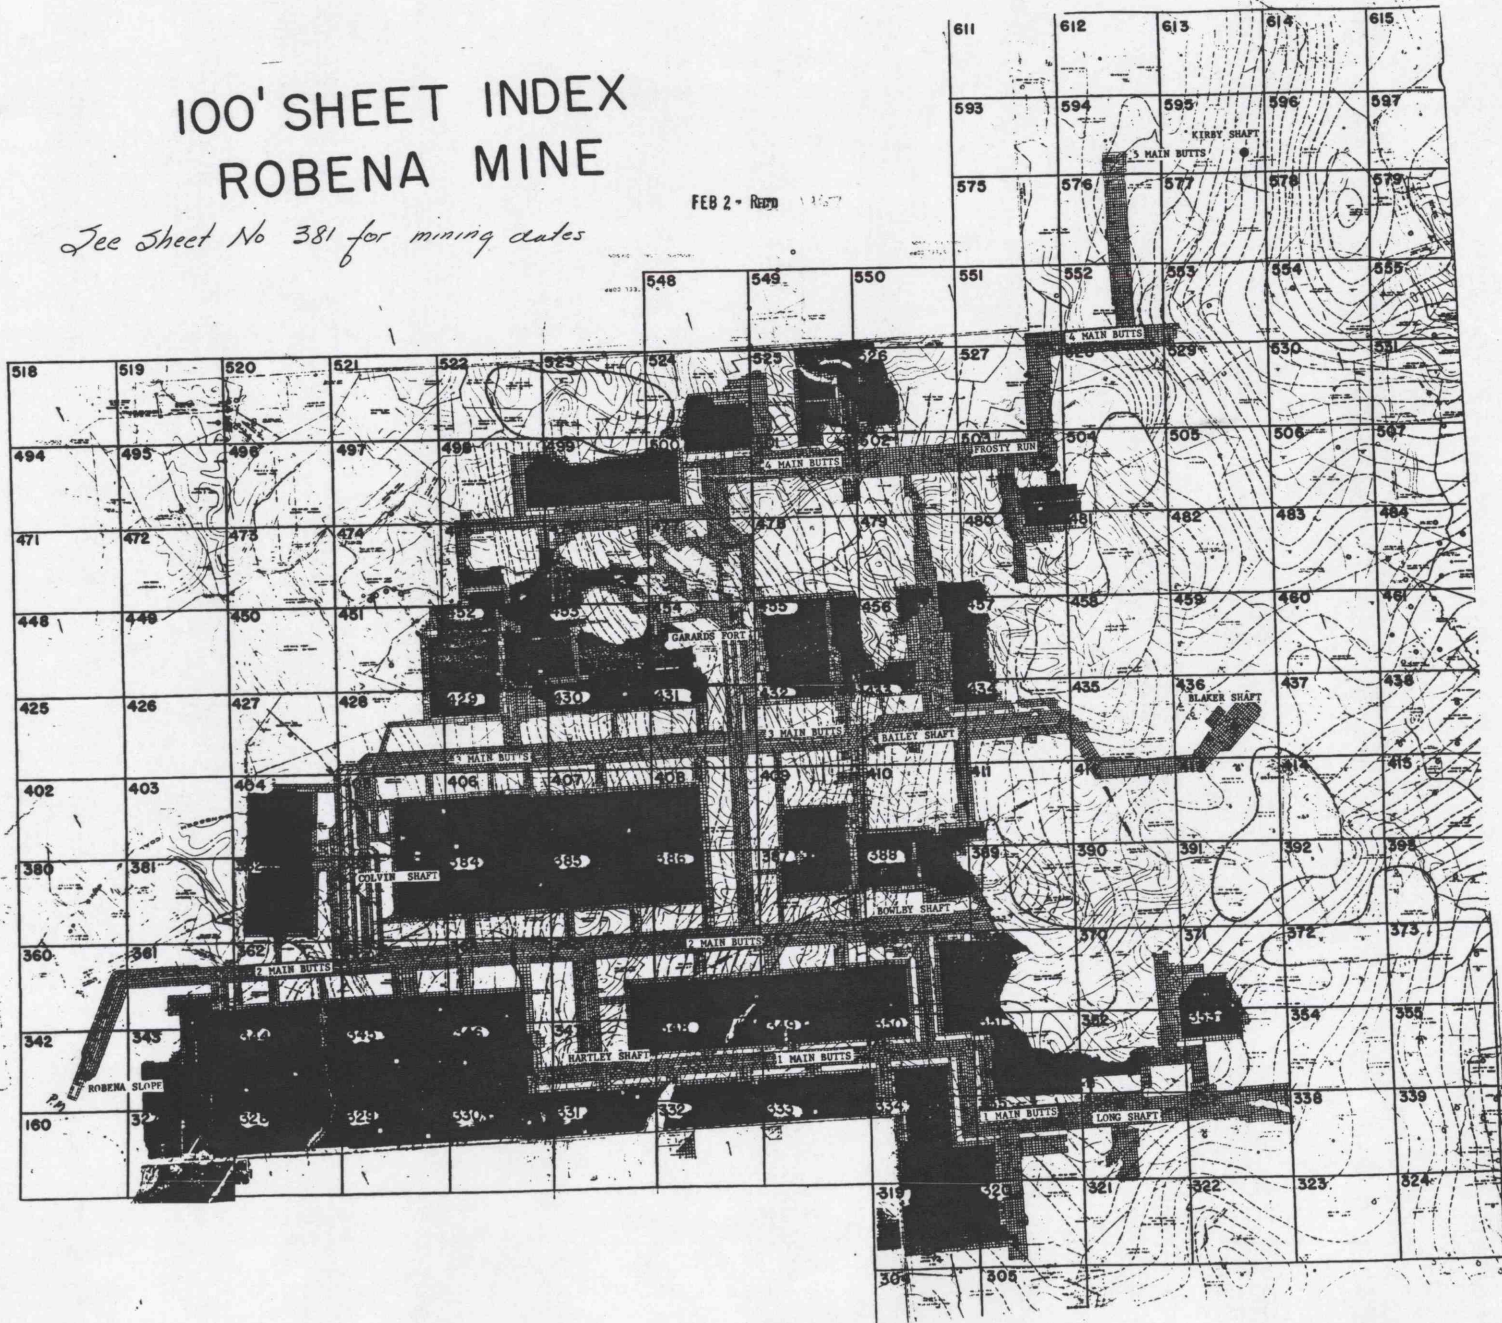

FEB 2 - Reord 1967

ROBENA-100-100