


RAYMOND BACHELIER
GRAMPAN, PA
LOCATION OF
MINE & COAL LAND
CLEARFIELD, PA
SEPT. 10, 1966
ROY C. KINDIG
REG. ENGR.

FIELD COPY

Mapped, edited, and published by the Geological Survey
Control by USGS and USC&GS


Topography from aerial photographs by photogrammetric methods
Aerial photographs taken 1957. Field check 1959
Polyconic projection. 1927 North American datum
10,000-foot grid based on Pennsylvania coordinate system,
north zone
1000-meter Universal Transverse Mercator grid ticks,
zone 17, shown in blue
Fine red dashed lines indicate selected fence and field lines
visible on aerial photographs. This information is unchecked

APPROXIMATE MEAN
MAGNETIC DECLINATION, 1959

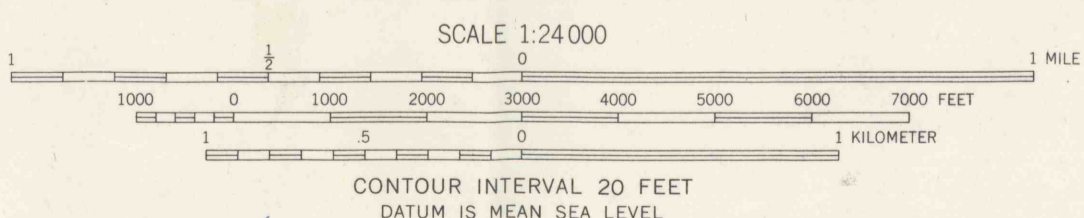

SCALE 1:24,000
CONTOUR INTERVAL 20 FEET
DATUM IS MEAN SEA LEVEL

ROAD CLASSIFICATION
Heavy-duty ——— Light-duty ———
Medium-duty ——— Unimproved dirt ———
U.S. Route ——— State Route ———

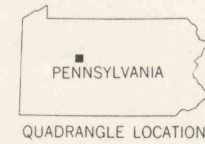

MAHAFFEY, PA.
NW 1/4 CURWENVILLE 15' QUADRANGLE
N4052.5 - W7837.5/7.5