


APPLICANT:
HERBERT F. BOLLINGER
812 SALT ST.
4490 SALTSBURG, PA.

BOLLINGER NO. 1
CONEMAUGH TWP.
INDIANA CO., PA.


LOCATED BY:
CHAS. KEAVETSKY
BOX 194
AVONMORE, PA.
R.S. 12782 E

Charles S. Keavetsky

Mapped, edited, and published by the Geological Survey
Control by USGS and USC&GS
Topography by photogrammetric methods from aerial photographs
taken 1962 and 1963. Field checked 1964
Polyconic projection. 1927 North American datum
10,000-foot grid based on Pennsylvania coordinate system, south zone
100-meter Universal Transverse Mercator grid ticks,
zone 17, shown in blue
Fine red dashed lines indicate selected fence and field lines where
generally visible on aerial photographs. This information is unchecked

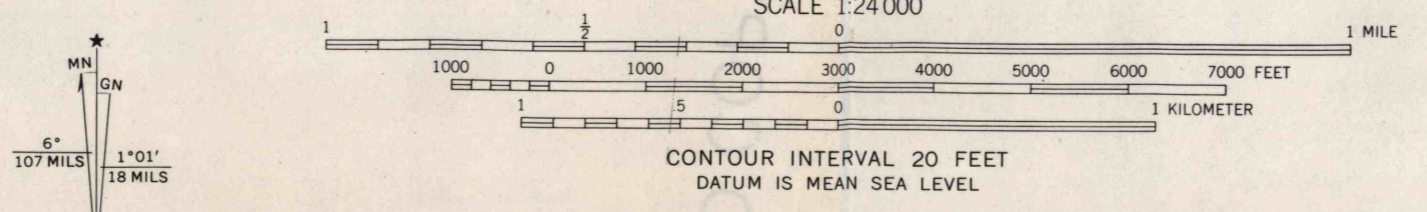

ROAD CLASSIFICATION
Heavy-duty ——— Light-duty ———
Medium-duty ——— Unimproved dirt ———
Slate Route ○

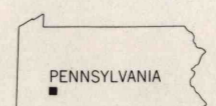

AVONMORE, PA.
QUADRANGLE LOCATION
CONEMAUGH TOWNSHIP
INDIANA COUNTY
PERMIT NUMBER-366-1
PITTSBURGH SEAM

THIS MAP COMPLIES WITH NATIONAL MAP ACCURACY STANDARDS
FOR SALE BY U. S. GEOLOGICAL SURVEY, WASHINGTON, D. C. 20242
A FOLDER DESCRIBING TOPOGRAPHIC MAPS AND SYMBOLS IS AVAILABLE ON REQUEST