


Mapped, edited, and published by the Geological Survey
Control by USGS and USC&GS
Topography from aerial photographs by photogrammetric methods
Aerial photographs taken 1952. Field check 1958
Polyconic projection. 1927 North American datum
10,000-foot grid based on Pennsylvania coordinate system,
zone 17, shown in blue
1000-meter Universal Transverse Mercator grid ticks,
zone 17, shown in blue
Fine red dashed lines indicate selected fence and field lines
visible on aerial photographs. This information is unchecked
Red tint indicates areas in which only
landmark buildings are shown
Contours in strip mine areas from 1952 photography
Unchecked elevations are shown in brown

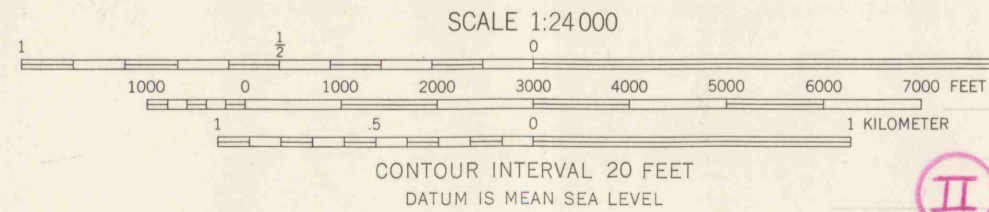

ROAD CLASSIFICATION
Heavy-duty ——— Light-duty ———
Medium-duty ——— Unimproved dirt ———
U.S. Route ——— State Route ———

ALLEGHENY RIVER MINING Co.
KITTANNING, PA.
CADDOGAN MINE NO. 2
SOUTH BUFFALO, NORTH BUFFALO & CADDOGAN TOWNS.
ARMSTRONG CO. OCT. 1966.

THIS MAP COMPLIES WITH NATIONAL MAP ACCURACY STANDARDS
FOR SALE BY U. S. GEOLOGICAL SURVEY, WASHINGTON 25, D. C.
A FOLDER DESCRIBING TOPOGRAPHIC MAPS AND SYMBOLS IS AVAILABLE ON REQUEST

KITTANNING, PA.
SE/4 KITTANNING 15' QUADRANGLE
N4045-W7930/7.5
1958
PERMIT NUMBER-161-3
"B"-OR LOWER KITTANNING SEAM

