


SAGER COAL CO.
 CHAMBERS MINE
 THOMAS SMITH, JR. R.S. 7094-E
Thomas Smith, Jr. 15 Aug 1966

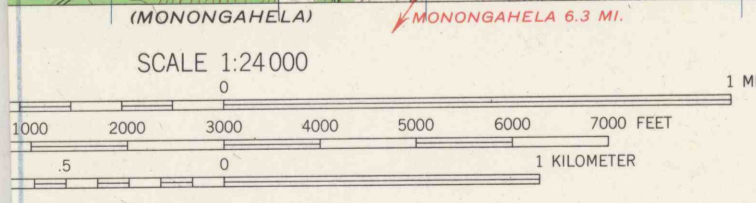

CONTOUR INTERVAL 20 FEET
 DATUM IS MEAN SEA LEVEL



ROAD CLASSIFICATION

Heavy-duty	Light-duty
Medium-duty	Unimproved dirt
○ State Route	

GLASSPORT, PA.
 SW/4 PITTSBURGH 15' QUADRANGLE
 N4015—W7952.5/7.5

1960

COMPLIES WITH NATIONAL MAP ACCURACY STANDARDS
 U. S. GEOLOGICAL SURVEY, WASHINGTON 25, D. C.
 A TOPOGRAPHIC MAPS AND SYMBOLS IS AVAILABLE ON REQUEST