



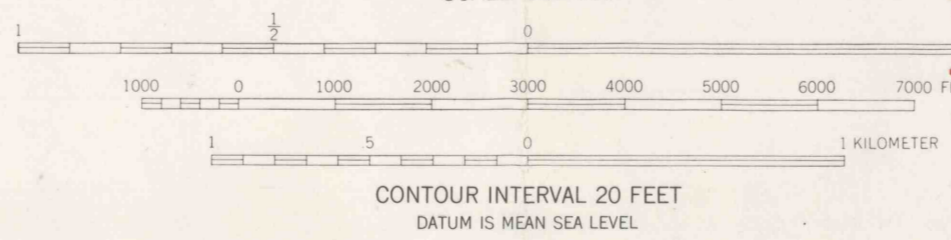

FIELD COPY


Mapped, edited, and published by the Geological Survey
Control by USGS and USC&GS
Topography from aerial photographs by multiplex methods
Aerial photographs taken 1952. Field check 1954
Polyconic projection. 1927 North American datum
10,000-foot grid based on Pennsylvania coordinate system, south zone
Contours in strip mine and mine dump areas compiled from 1952 photography.
1000-meter Universal Transverse Mercator grid ticks, zone 17, shown in blue

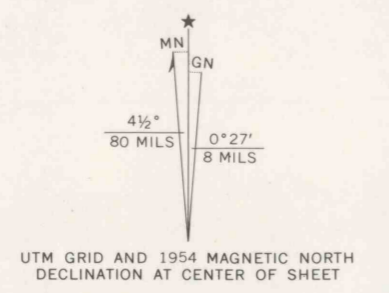

MT. PLEASANT TOWNSHIP
WASHINGTON COUNTY
PERMIT NUMBER-164-1
PITTSBURGH SEAM

ROAD CLASSIFICATION

Heavy-duty	Light-duty
Medium-duty	Unimproved dirt
U. S. Route	State Route

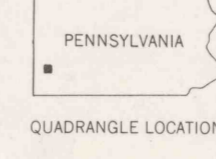

MIDWAY, PA.
SE/4 BURGETTSTOWN 15' QUADRANGLE
N4015-W8015/7.5

THIS MAP COMPLIES WITH NATIONAL MAP ACCURACY STANDARDS
FOR SALE BY U. S. GEOLOGICAL SURVEY, WASHINGTON 25, D. C.
A FOLDER DESCRIBING TOPOGRAPHIC MAPS AND SYMBOLS IS AVAILABLE ON REQUEST

PEN-OR-WES-MAP COMPANY
PHONE 281-0845 511 MABEE BLDG
336 FOURTH AVENUE PHN PA 15229

1954
AMS 4964 IV SE-SERIES V831