


MAY 31 1974

COOPER, LINDA  
MOORE, GEORGE  
BROWN, GERALD  
WIDE WOOD ROAD  
E.H. FENNELL

DU BOIS QUADRANGLE  
PENNSYLVANIA  
7.5 MINUTE SERIES (TOPOGRAPHIC)  
SE/4 DU BOIS 15' QUADRANGLE

UNITED STATES  
DEPARTMENT OF THE INTERIOR  
GEOLOGICAL SURVEY

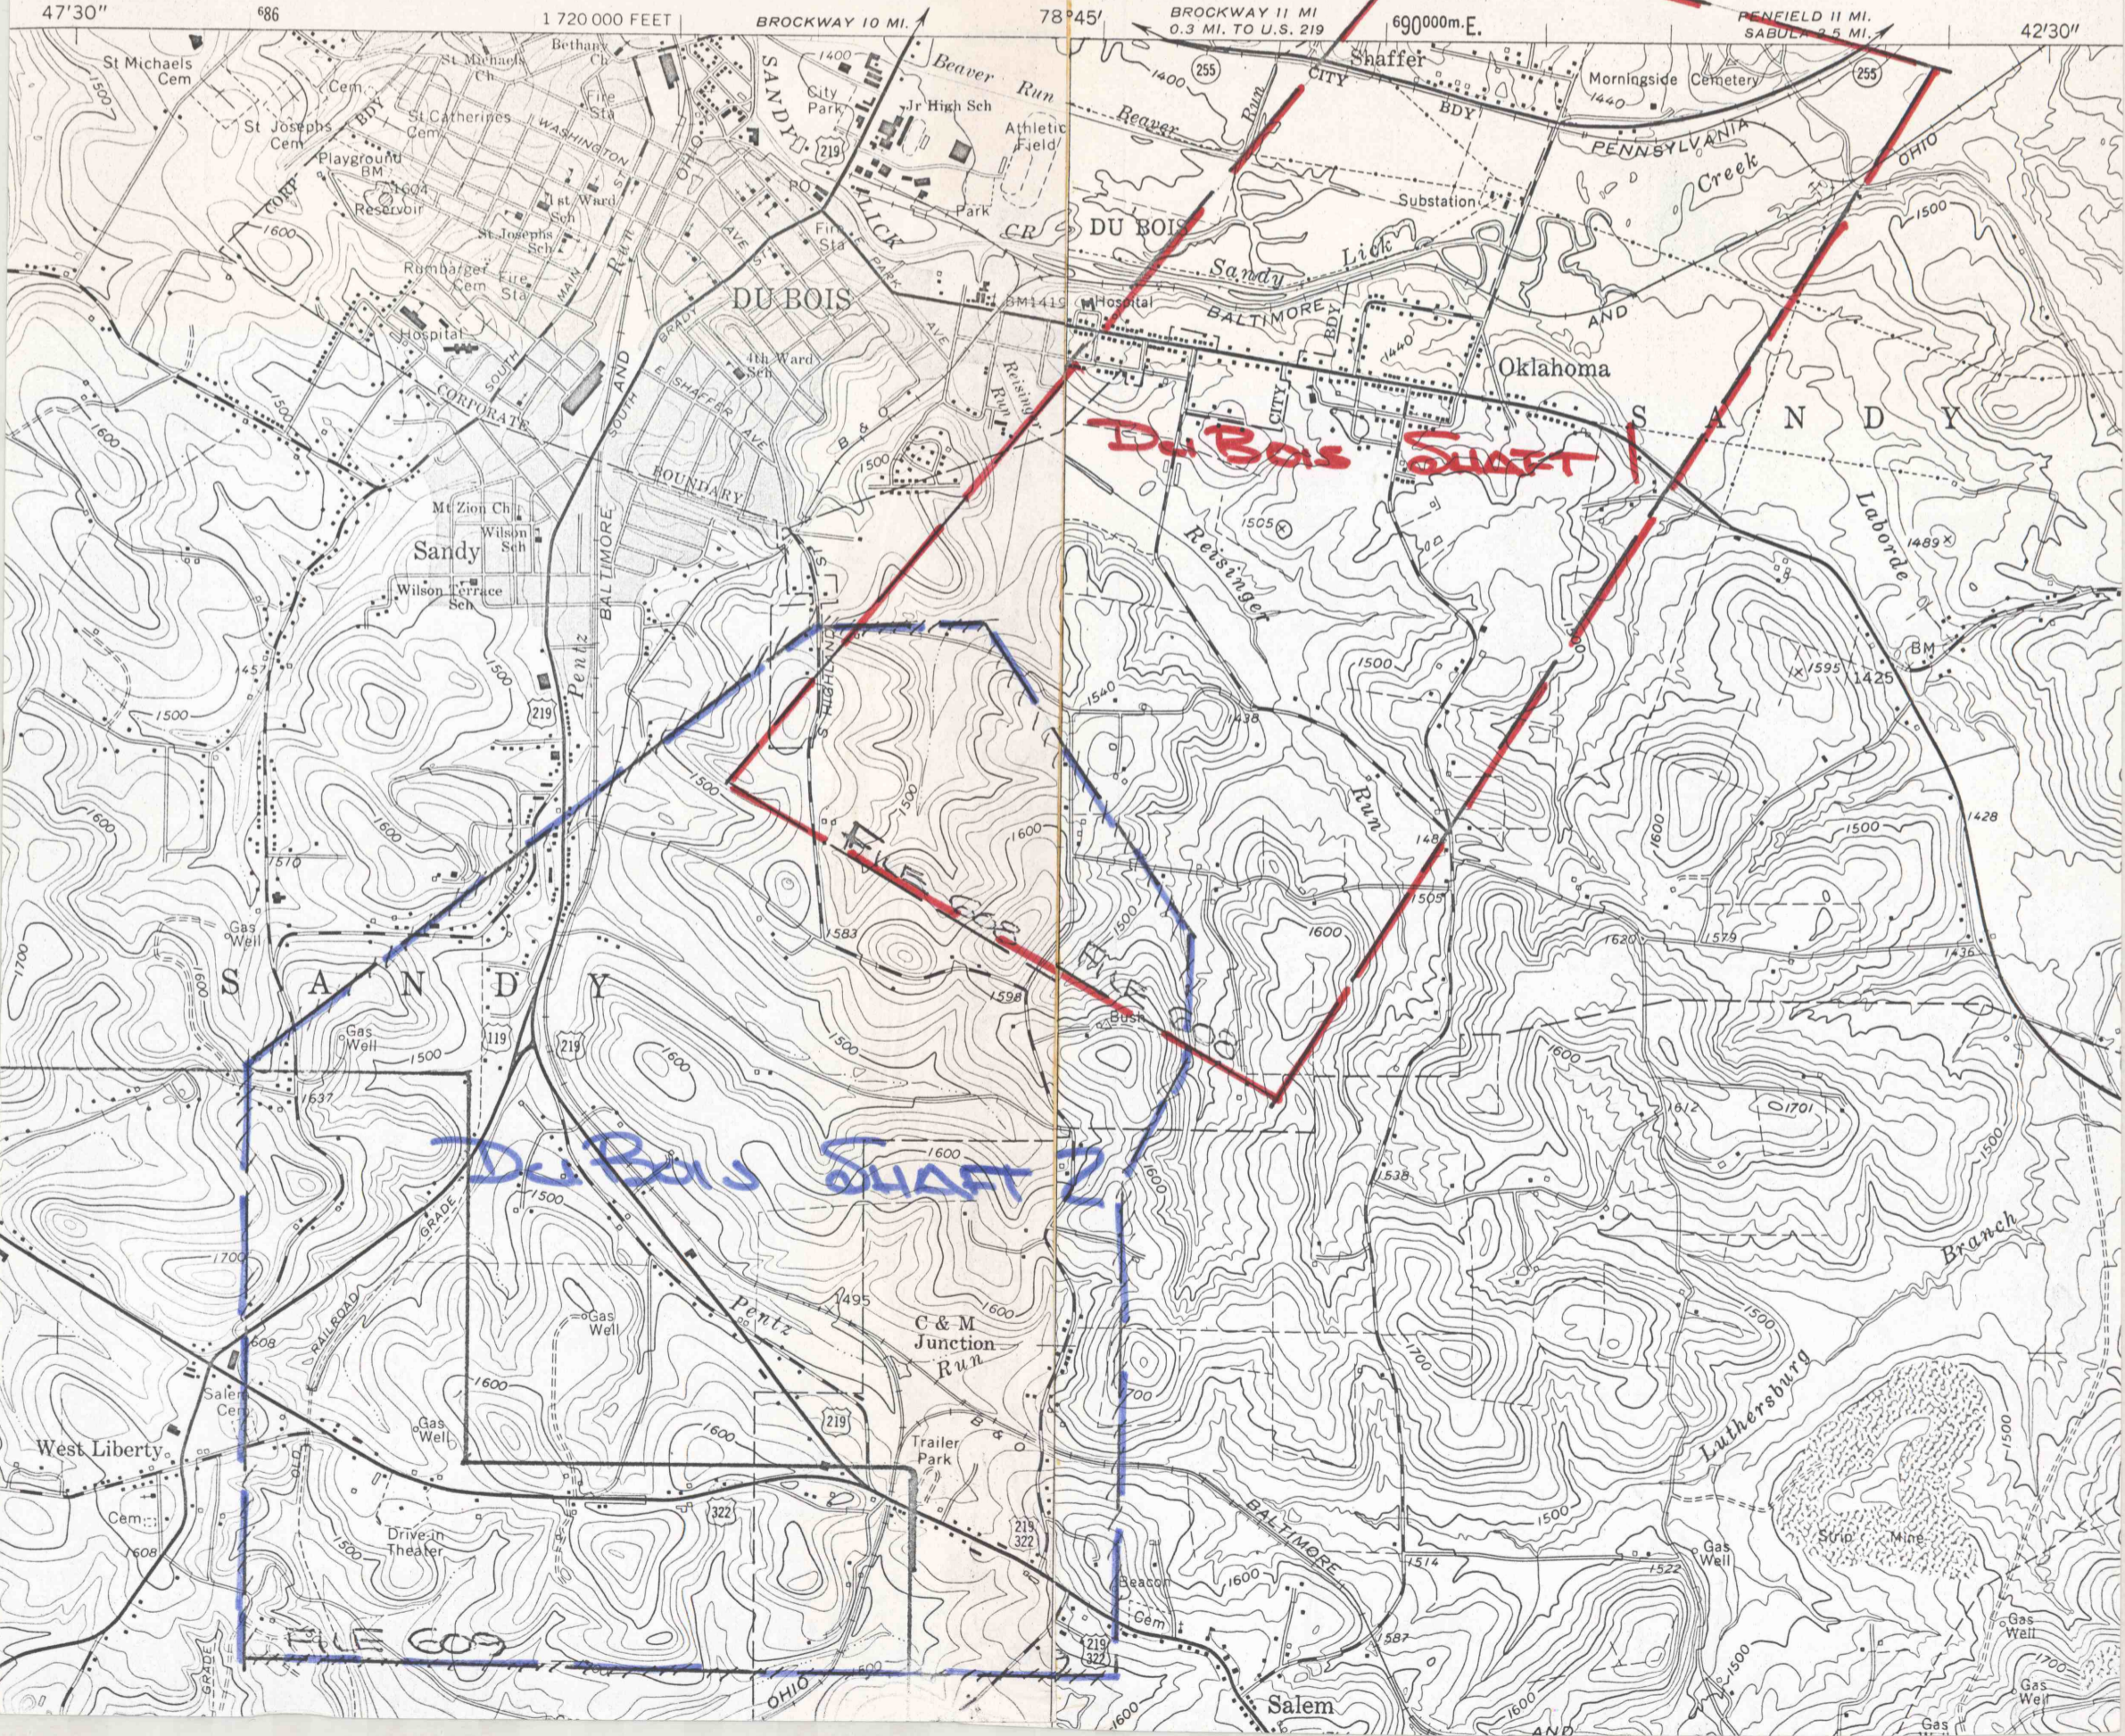

Du Bois Shaft 1

Du Bois Shaft 2

FILE 609