



**FRICANO  
COAL CO.**  
Mine located on  
Map by George Gera  
Feb. 1967

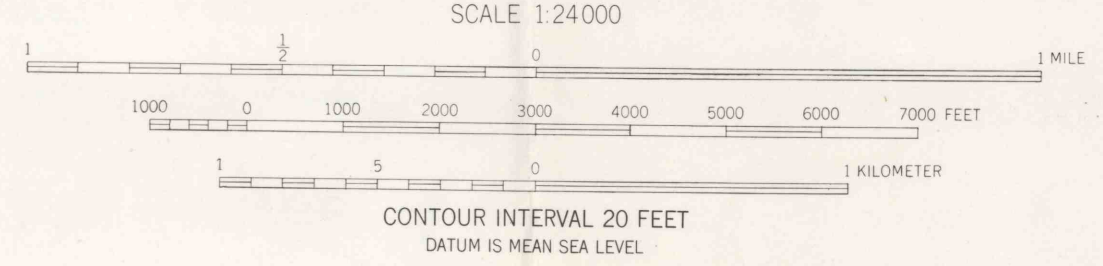

Mapped, edited, and published by the Geological Survey  
Control by USGS and USC&GS  
Topography from aerial photographs by multiplex methods  
Aerial photographs taken 1952. Field check 1954  
Polyconic projection. 1927 North American datum  
10,000-foot grid based on Pennsylvania coordinate system,  
south zone  
Contours in strip mine and mine dump areas  
compiled from 1952 photography  
All mining features on this map are inactive  
unless otherwise indicated  
1000-meter Universal Transverse Mercator grid ticks,  
zone 17, shown in blue

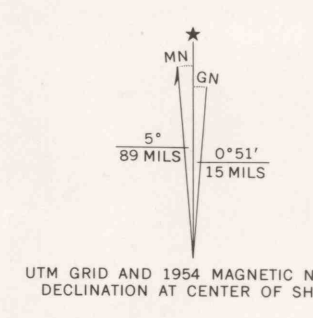

ROAD CLASSIFICATION

Heavy-duty	Light-duty
Medium-duty	Unimproved dirt
U.S. Route	State Route



SMITHTON, PA.  
NW/4 CONNELLSVILLE 15' QUADRANGLE  
N4007.5-W7937.5/7.5  
1954  
AMS 5064 II NW-SERIES V831

THIS MAP COMPLIES WITH NATIONAL MAP ACCURACY STANDARDS  
FOR SALE BY U.S. GEOLOGICAL SURVEY, WASHINGTON, D. C. 20242  
A FOLDER DESCRIBING TOPOGRAPHIC MAPS AND SYMBOLS IS AVAILABLE ON REQUEST

**SOUTH HUNTINGDON TOWNSHIP  
WESTMORELAND COUNTY  
PERMIT NUMBER- 279-1  
"E"-OR UPPER FREEPORT SEAM**