


FIELD COPY
COOPER TOWNSHIP
CLEARFIELD COUNTY
PERMIT NUMBER - 229-1
"A" OR BROOKVILLE SEAM
ANDREW FEWUSH DEEP MINE
BROOKVILLE "A" SEAM
DRIFTING, PA.
12-12-66 ALLEN G. BUTLER R.R.E.

Mapped, edited, and published by the Geological Survey
Control by USGS and USC&GS
Topography from aerial photographs by photogrammetric methods
Aerial photographs taken 1958. Field check 1959
Polyconic projection. 1927 North American datum
10,000-foot grid based on Pennsylvania coordinate system,
north zone
1000-meter Universal Transverse Mercator grid ticks,
zone 17, shown in blue
Fine red dashed lines indicate selected fence and field lines where
generally visible on aerial photographs. This information is unchecked

75°
TRUE NORTH
MAGNETIC NORTH
APPROXIMATE MEAN
DECLINATION, 1959

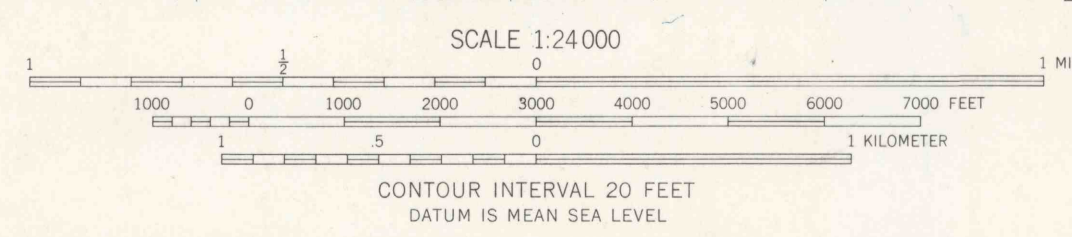

ROAD CLASSIFICATION

Heavy-duty	Light-duty
Medium-duty	Unimproved dirt
○ State Route	



KARTHAUS, PA.
SE 1/4 KARTHAUS 15' QUADRANGLE
N 4100-W 7800/7.5
1959

THIS MAP COMPLIES WITH NATIONAL MAP ACCURACY STANDARDS
FOR SALE BY U.S. GEOLOGICAL SURVEY, WASHINGTON 25, D. C.
A FOLDER DESCRIBING TOPOGRAPHIC MAPS AND SYMBOLS IS AVAILABLE ON REQUEST*