

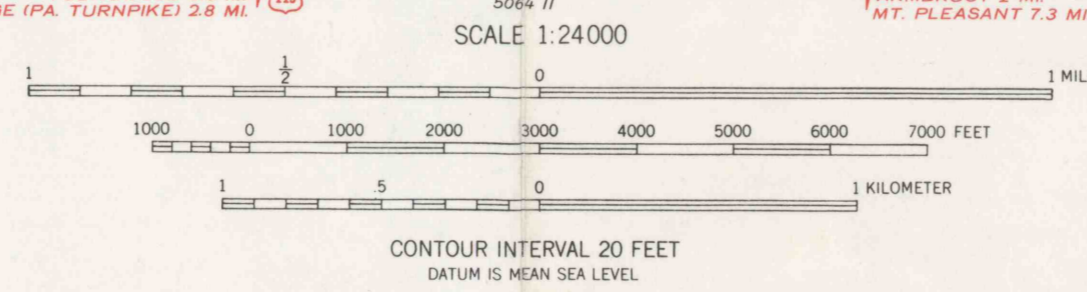


Mapped, edited, and published by the Geological Survey  
Control by USGS and USC&GS  
Topography from aerial photographs by multiplex methods  
Aerial photographs taken 1952. Field check 1954  
Polyconic projection. 1927 North American datum  
1000-meter Universal Transverse Mercator grid ticks,  
zone 17, shown in blue  
Red tint indicates areas in which only  
landmark buildings are shown  
Contours in strip mine and mine dump areas compiled  
from 1952 photography. Broken contours in strip mine areas  
indicate mining since photography. All strip mines are inactive  
All wells shown are active gas wells

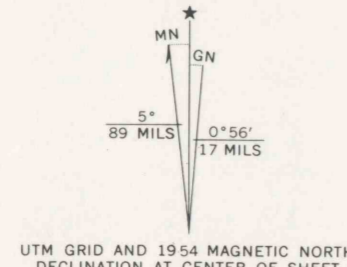

ROAD CLASSIFICATION

Heavy-duty	Light-duty
Medium-duty	Unimproved dirt
U.S. Route	State Route

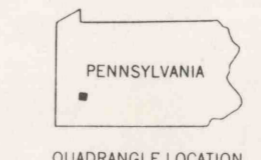

THIS MAP COMPLIES WITH NATIONAL MAP ACCURACY STANDARDS  
FOR SALE BY U.S. GEOLOGICAL SURVEY, WASHINGTON 25, D.C.  
A FOLDER DESCRIBING TOPOGRAPHIC MAPS AND SYMBOLS IS AVAILABLE ON REQUEST

**HEMPFIELD TOWNSHIP  
WESTMORELAND COUNTY  
PERMIT NUMBER - 43-1  
PITTSBURGH SEAM FIELD COPY**

GREENSBURG, PA.  
SE 1/4 GREENSBURG 15 QUADRANGLE  
N4015-W7930/7.5  
1954  
AMS 5064 1 SE-SERIES V831

