



*Applicant: John Melton
For: John Melton Coal Co
April 15, 1968
Mine located by Don Cortese P.S.*

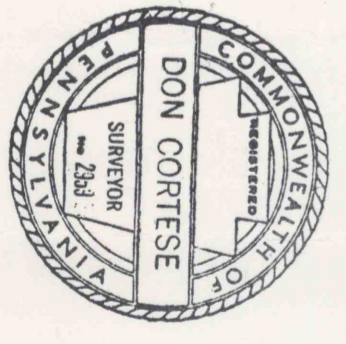


Mapped, edited, and published by the Geological Survey
Control by USGS and USC&GS
Topography by photogrammetric methods from aerial
photographs taken 1962. Field checked 1963
Polyconic projection, 1927 North American datum
10,000-foot grid based on Pennsylvania coordinate system, south zone
1000-meter Universal Transverse Mercator grid ticks,
zone 17, shown in blue
Fine red dashed lines indicate selected fence and field lines where
generally visible on aerial photographs. This information is unchecked.

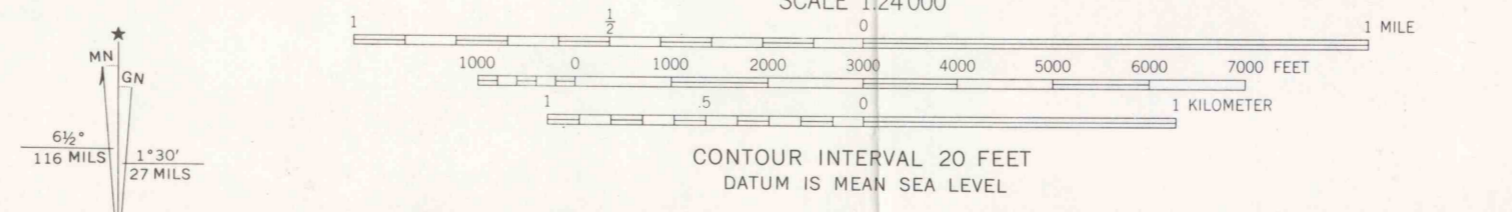

ROAD CLASSIFICATION

Medium-duty	Light-duty
Unimproved dirt	State Route

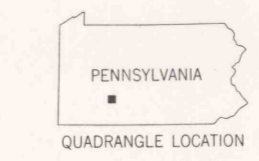

**ADAMS TOWNSHIP
CAMBRIA COUNTY
PERMIT NUMBER - 361-1
"D"-OR LOWER FREEPORT SEAM**

THIS MAP COMPLIES WITH NATIONAL MAP ACCURACY STANDARDS
FOR SALE BY U.S. GEOLOGICAL SURVEY, WASHINGTON, D. C. 20242
A FOLDER DESCRIBING TOPOGRAPHIC MAPS AND SYMBOLS IS AVAILABLE ON REQUEST

BEAVERDALE, PA.
SW/4 EBENSBURG 15' QUADRANGLE
N4015-W7837.5/7.5
1963
AMS 5264 1 SW-SERIES V831