




Maped, edited, and published by the Geological Survey  
Control by USGS and USC&GS  
Topography by photogrammetric methods from aerial  
photographs taken 1958. Field checked 1961  
Polyconic projection. 1927 North American datum  
10,000-foot grid based on Pennsylvania coordinate system,  
south zone  
1000-meter Universal Transverse Mercator grid ticks,  
zone 17, shown in blue  
Fine red dashed lines indicate selected fence and field lines where  
generally visible on aerial photographs. This information is unchecked


TRUE NORTH  
MAGNETIC NORTH  
APPROXIMATE MEAN  
DECLINATION, 1961

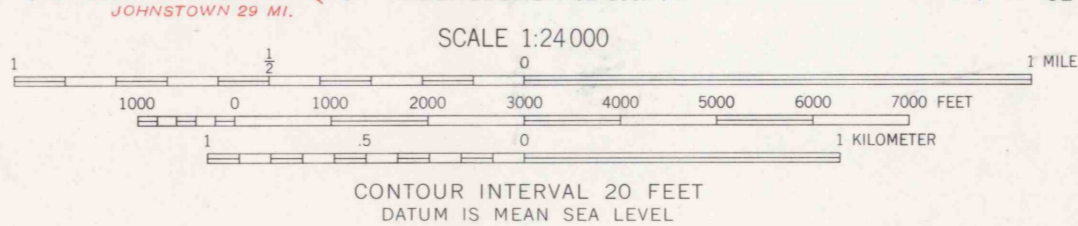

**MYERS DRIFT AND  
PORTION OF DELANEY  
NO. 5 MINE**  
GALLITZIN TOWNSHIP  
CAMBRIA COUNTY,  
PENNSYLVANIA

**JAMES LEGO, OPERATOR**  
**PERMIT NUMBER - 157-1**  
**"E" - OR UPPER FREEPORT SEAM**

ROAD CLASSIFICATION  
Heavy-duty ——— Light-duty ———  
Medium-duty ——— Unimproved dirt ———  
State Route

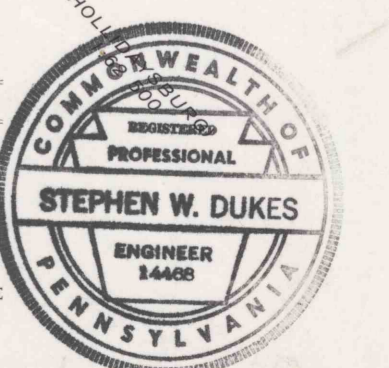

ASHVILLE, PA.  
SE 4 PATTON 15' QUADRANGLE  
N4030-W7830/7.5  
1963  
FIELD COPY

THIS MAP COMPLIES WITH NATIONAL MAP ACCURACY STANDARDS  
FOR SALE BY U. S. GEOLOGICAL SURVEY, WASHINGTON 25, D. C.  
A FOLDER DESCRIBING TOPOGRAPHIC MAPS AND SYMBOLS IS AVAILABLE ON REQUEST