





NORTH CAMP #2  
NORTH CAMP #2 MINE  
OF  
NORTH CAMP MINING CO.  
LA JOSE, PA.  
BY: George T. Jones  
P.E.  
#14254  
NEW FLORENCE, PA.

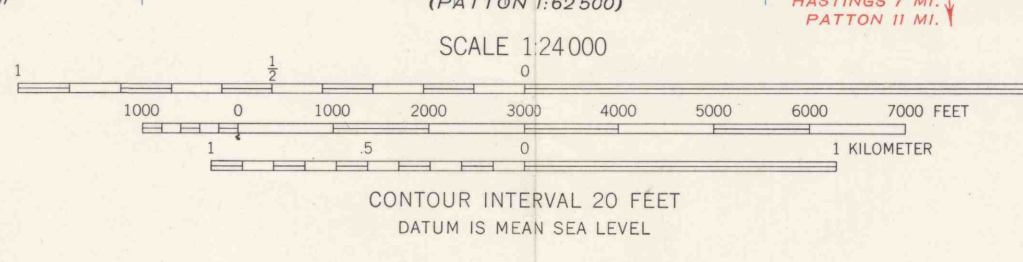

Mapped, edited, and published by the Geological Survey  
Control by USGS and USC&GS  
Topography from aerial photographs by photogrammetric methods  
Aerial photographs taken 1957. Field check 1959  
Polyconic projection. 1927 North American datum  
10,000-foot grid based on Pennsylvania coordinate system,  
north zone  
1000-meter Universal Transverse Mercator grid ticks,  
zone 17, shown in blue  
Fine red dashed lines indicate selected fence and field lines  
visible on aerial photographs. This information is unchecked  
Unchecked elevations are shown in brown



ROAD CLASSIFICATION  
Heavy-duty ——— Light-duty ———  
Medium-duty ——— Unimproved dirt - - - - -  
○ State Route

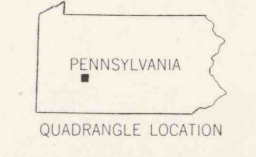

WESTOVER, PA.  
SW 1/4 CURWENSVILLE 15' QUADRANGLE  
N 4045—W 7837.5/7.5

THIS MAP COMPLIES WITH NATIONAL MAP ACCURACY STANDARDS  
FOR SALE BY U. S. GEOLOGICAL SURVEY, WASHINGTON 25, D. C.  
A FOLDER DESCRIBING TOPOGRAPHIC MAPS AND SYMBOLS IS AVAILABLE ON REQUEST

1959  
PEN-ON-WES-MAP COMPANY  
PHONE 281-0848 511 MABEE BLDG.  
338 FOURTH AVE. - PENN. PA. 15222  
**CHEST TOWNSHIP  
CLEARFIELD COUNTY  
PERMIT NUMBER - 111-2  
C-PRIME-OR UPPER KITTANNING SEAM**