


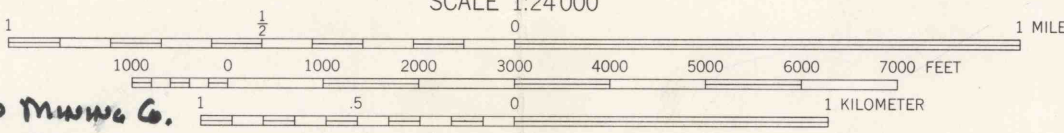

Mapped, edited, and published by the Geological Survey
Control by USGS and USC&GS
Topography from aerial photographs by photogrammetric methods
Aerial photographs taken 1957. Field check 1959
Polyconic projection. 1927 North American datum
10,000-foot grid based on Pennsylvania coordinate system,
north zone
1000-meter Universal Transverse Mercator grid ticks,
zone 17, shown in blue
Fine red dashed lines indicate selected fence and field lines
visible on aerial photographs. This information is unchecked
Unchecked elevations are shown in brown


NORTH CAMP MINE CO.
NORTH CAMP #2 MINE
LA JOSE, PA.
George A. Jones, P.E.
NEW FLORENCE, PA.
15944

CONTOUR INTERVAL 20 FEET
DATUM IS MEAN SEA LEVEL



ROAD CLASSIFICATION

Heavy-duty	Light-duty
Medium-duty	Unimproved dirt
State Route	

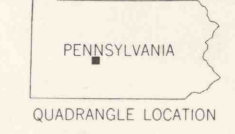

IRVONA, PA.
SE/4 CURWENSVILLE 15' QUADRANGLE
N 4045—W 7830/7.5

CHEST TOWNSHIP
CLEARFIELD COUNTY
PERMIT NUMBER - 111-2
C-PRIME-OR UPPER KITTANNING SEAM

THIS MAP COMPLIES WITH NATIONAL MAP ACCURACY STANDARDS
FOR SALE BY U. S. GEOLOGICAL SURVEY, WASHINGTON 25, D. C.
A FOLDER DESCRIBING TOPOGRAPHIC MAPS AND SYMBOLS IS AVAILABLE ON REQUEST