


BRUSH VALLEY, PA.

N4030—W7900/7.5

1963  
PHOTOREVISED 1981  
DMA 5165 II SE—SERIES V831

STRONGSTOWN, PA.

N4030—W7852.5/7.5  
PHOTOINSPECTED 1977  
1961  
PHOTOREVISED 1972  
AMS 8265 III BW—SERIES V831

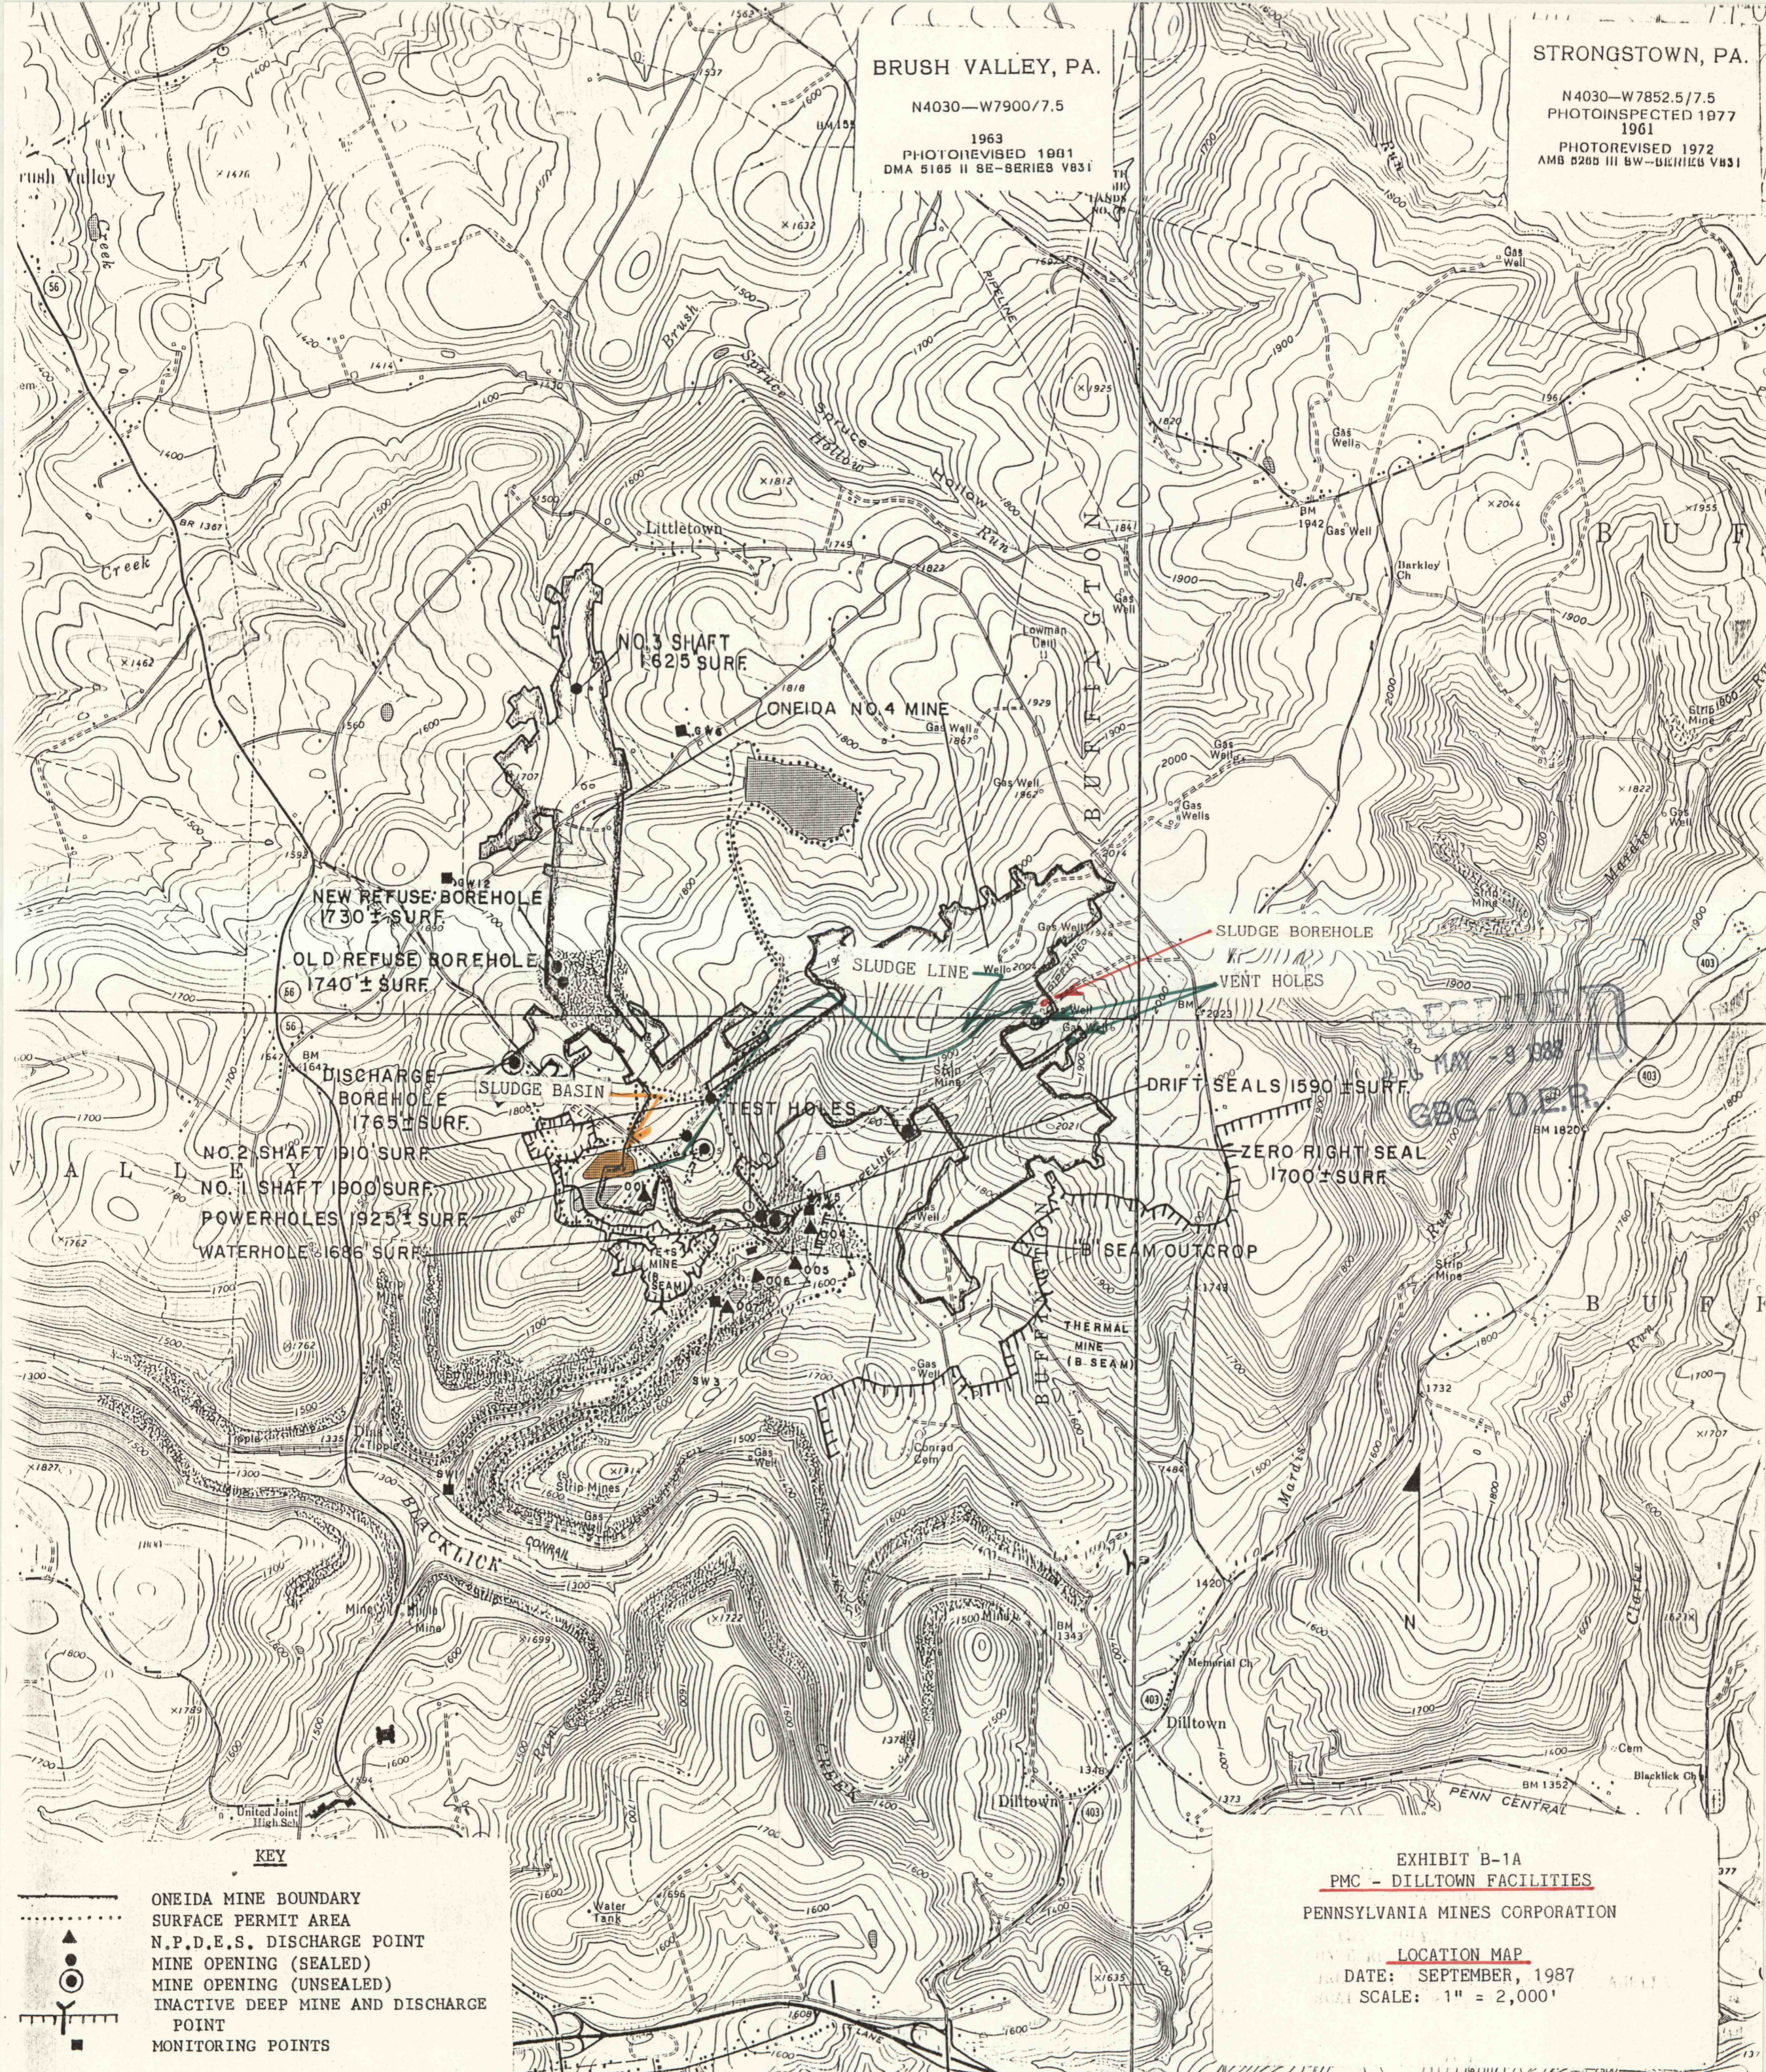

**KEY**

- ONEIDA MINE BOUNDARY
- SURFACE PERMIT AREA
- N.P.D.E.S. DISCHARGE POINT
- MINE OPENING (SEALED)
- MINE OPENING (UNSEALED)
- INACTIVE DEEP MINE AND DISCHARGE POINT
- MONITORING POINTS

EXHIBIT B-1A  
PMC - DILLTOWN FACILITIES  
PENNSYLVANIA MINES CORPORATION

LOCATION MAP  
DATE: SEPTEMBER, 1987  
SCALE: 1" = 2,000'

NEW FLORENCE, PA.

N4022.5—W7900/7.5

1964  
PHOTOREVISED 1981  
DMA 5164 I NE—SERIES V831

VINTONDALE, PA.

N4022.5—W7852.5/7.5

1964  
PHOTOREVISED 1972  
AMS 5264 IV NW—SERIES V831