



ELENSKY BROTHERS
OWENS #1
SEPT. 13, 1966

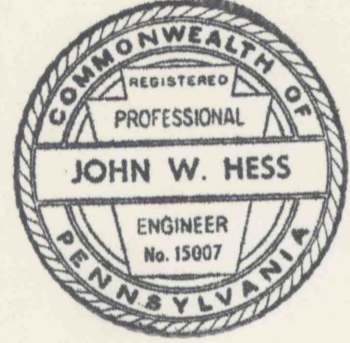

Mapped by the Geological Survey
1944

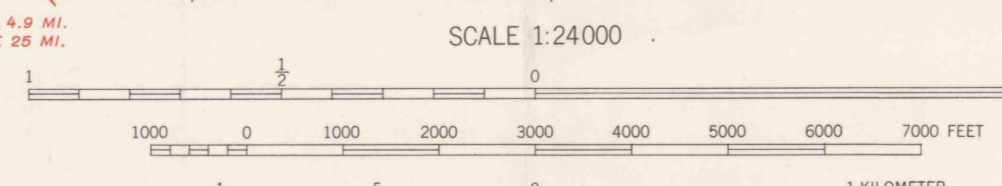

INTERIOR - GEOLOGICAL SURVEY, WASHINGTON, D. C. 1956
Polyconic projection. 1927 North American datum
5000 yard grid based on U. S. zone system, B
10000 foot grid based on Pennsylvania (North)
rectangular coordinate system

ROAD CLASSIFICATION
Heavy-duty — 4 LANE 16 LANE Light-duty — 2 LANE 16 LANE
Medium-duty — 4 LANE 16 LANE Unimproved dirt — 2 LANE 16 LANE
U. S. Route State Route

APPROXIMATE MEAN DECLINATION, 1944

Contour interval 20 feet
Datum is mean sea level

GLEN RICHEY, PA.

N4052.5-W7822.5/7.5
1944

**LAWRENCE TOWNSHIP
CLEARFIELD COUNTY
PERMIT NUMBER - 62-1
"E"-OR UPPER FREEPORT SEAM**

FOR SALE BY U. S. GEOLOGICAL SURVEY, WASHINGTON 25, D. C.
A FOLDER DESCRIBING TOPOGRAPHIC MAPS AND SYMBOLS IS AVAILABLE ON REQUEST

FIELD COPY