



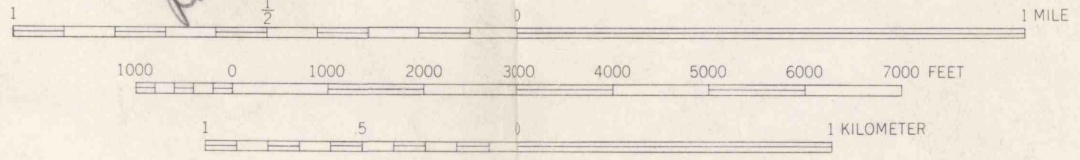


Mapped, edited, and published by the Geological Survey
Control by USGS and USC&GS
Topography from aerial photographs by multiplex methods
Aerial photographs taken 1952. Field check 1953
Polyconic projection. 1927 North American datum
10,000-foot grid based on Pennsylvania coordinate system,
south zone
Red tint indicates areas in which only landmark
buildings are shown
Contours in strip mine and mine dump areas
compiled from 1952 photography
1000-meter Universal Transverse Mercator grid ticks,
zone 17, shown in blue

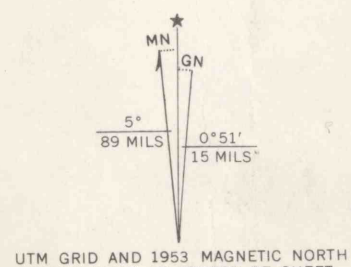

Prepared By *Herman H. Dedimon*
Reg Surveyor - 483 E
152 Plum Ave - Pittsburgh Pa. 15239
THIS MAP COMPLEYS WITH NATIONAL MAP ACCURACY STANDARDS
FOR SALE BY U. S. GEOLOGICAL SURVEY, WASHINGTON 25, D. C.
A FOLDER DESCRIBING TOPOGRAPHIC MAPS AND SYMBOLS IS AVAILABLE ON REQUEST

ROAD CLASSIFICATION
Heavy-duty ——— Light-duty ———
Medium-duty ——— Unimproved dirt ———
U. S. Route ——— State Route ———

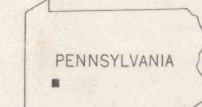

NEW KENSINGTON EAST, PA.
SW/4 FREEPORT 15 QUADRANGLE
N4030-W7937.5/7.5

FRANKLIN TOWNSHIP
WESTMORELAND COUNTY 1953
PERMIT NUMBER 7-1 AMS 5065 II SW-SERIES V831
PITTSBURGH SEAM