



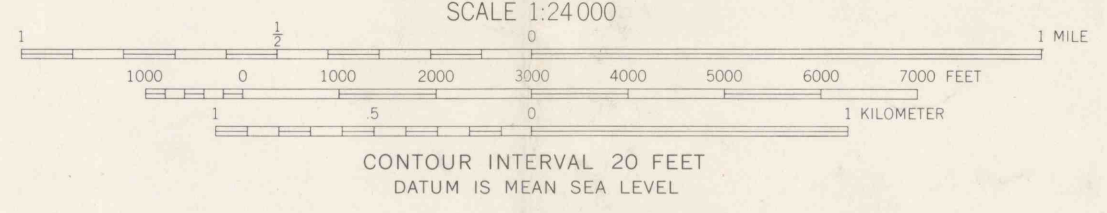

*mine operation
Drainage to Clearfield Creek
Area to be mined 1 acre
By Ray a. Hill RS*

Mapped, edited, and published by the Geological Survey
Control by USGS and USCGS
Topography by photogrammetric methods from aerial photographs taken 1962. Field checked 1963
Polyconic projection. 1927 North American datum
10,000-foot grid based on Pennsylvania coordinate system, south zone
1000-meter Universal Transverse Mercator grid ticks, zone 17, shown in blue
Fine red dashed lines indicate selected fence and field lines where generally visible on aerial photographs. This information is unchecked

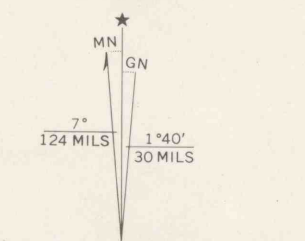

ROAD CLASSIFICATION
Heavy-duty ——— Light-duty ———
Medium-duty ——— Unimproved dirt ———
○ State Route

DOMENICK ROBERTS
425-4 Avenue Altoona Pa

**DEAN TOWNSHIP
CAMBRIA COUNTY
PERMIT NUMBER - 341-1
C-PRIME - OR UPPER KITTANNING SEAM**

THIS MAP COMPLIES WITH NATIONAL MAP ACCURACY STANDARDS
FOR SALE BY U. S. GEOLOGICAL SURVEY, WASHINGTON 25, D. C.
A FOLDER DESCRIBING TOPOGRAPHIC MAPS AND SYMBOLS IS AVAILABLE ON REQUEST

FIELD COPY

BLANDBURG, PA.
NW/4 ALTOONA 15' QUADRANGLE
N4037.5-W7822.5/7.5
1963
AMS 5365 III NW-SERIES V831