
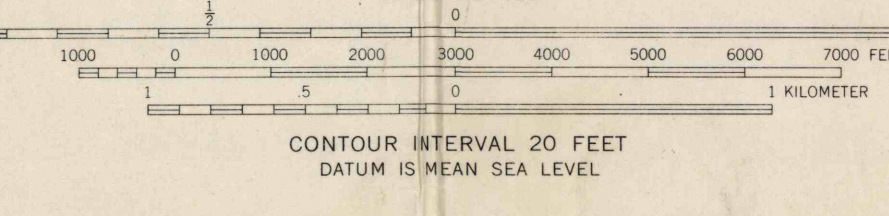


Mapped, edited, and published by the Geological Survey  
Control by USGS and USC&GS  
Topography by photogrammetric methods from aerial photographs taken 1962. Field checked 1964  
Polyconic projection, 1927 North American datum  
10 000-foot grid based on Pennsylvania coordinate system, south zone  
1000-meter Universal Transverse Mercator grid ticks, zone 17, shown in blue  
Red tint indicates areas in which only landmark buildings are shown  
Fine red dashed lines indicate selected fence and field lines where generally visible on aerial photographs. This information is unchecked  
Reservation boundary from maps by U. S. Corps of Engineers  
Areas covered by dashed light-blue pattern are subject to controlled inundation by Loyahanna Dam

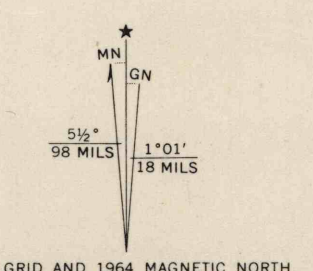


**UNITY TOWNSHIP  
WESTMORELAND COUNTY  
PERMIT NUMBER - 47-1  
PITTSBURGH SEAM**

ROAD CLASSIFICATION  
Heavy-duty ——— Light-duty ———  
Medium-duty ——— Unimproved dirt ———  
U. S. Route ——— State Route ———

LATROBE, PA.  
SW/4 LATROBE 15' QUADRANGLE  
N4015—W7922.5/7.5  
1964  
AMS 5164 IV SW—SERIES V831

PEN-ON-WES-MAP COMPANY,  
PHONE 261-0645 511 MABEE BLDG  
309 FOURTH AVE. - PBN, PA 15227

ST. VINCENT MINE  
LOCATED ON MAP  
By George Gera  
Latrobe, Pa.  
8-66

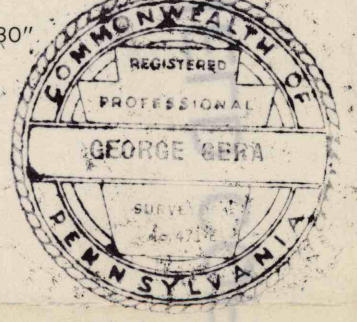

THIS MAP COMPLIES WITH NATIONAL MAP ACCURACY STANDARDS  
FOR SALE BY U. S. GEOLOGICAL SURVEY, WASHINGTON, D. C. 20242  
A FOLDER DESCRIBING TOPOGRAPHIC MAPS AND SYMBOLS IS AVAILABLE ON REQUEST